


Map No. _____ Sec. 2 Twp. 26 R. 8Well No. 17 Hull FarmTidal & G. Southern Company

NORTH

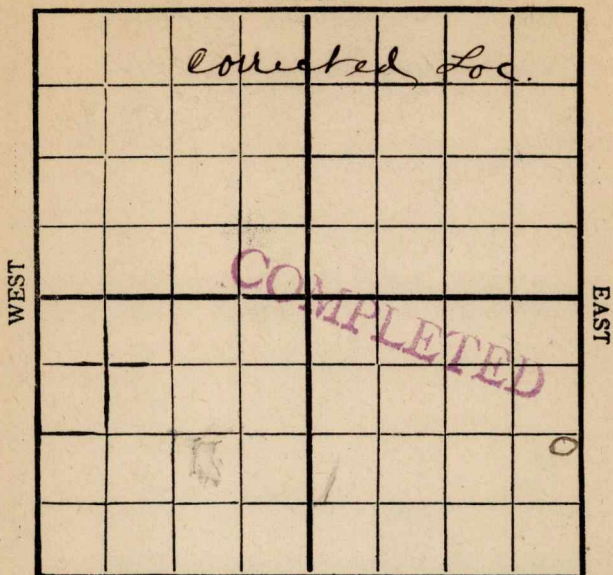

SOUTH

Location _____

Rig Up _____

Drilling Remarks:

Drilling Remarks:

8-23-19Sand 1326'Abandoned1359' Dry &1377'

RECORD

Cased _____ in. _____ ft.

Sand _____

Gas _____

Oil _____

Total Depth _____

PRODUCTION

1st 24 hrs. Nat. _____

1st 24 hrs. after shot _____

Gas _____ cu. ft.

Dry Hole _____

Abandoned _____


Map No. K15 Sec. 2 Twp. 26 R. 2Well No. 17 Hyll
Tidal & St. Southern Company

Contractor

NORTH

WEST

EAST

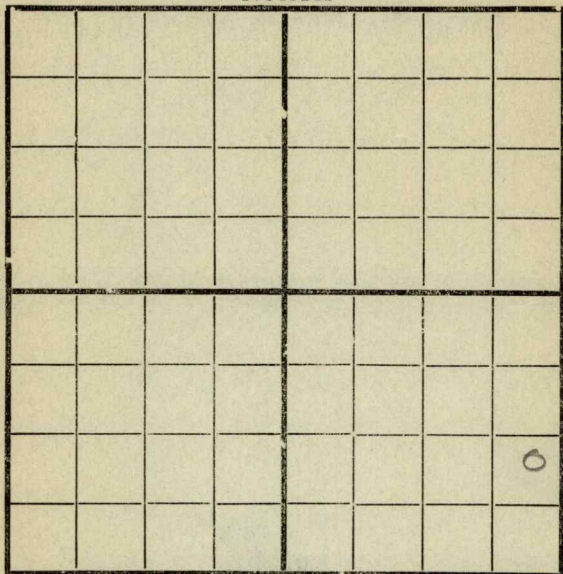

SOUTH

1190 S250 E

Location

Rig up

Drilling and Remarks:

2300'

RECORD

Cased _____ in., _____ ft.

Sand _____

Gas _____

Oil _____

Total Depth _____

PRODUCTION

1st 24 hrs. Nat. _____

1st 24 hrs. after shot _____

Gas _____ Cu. Ft.

Dry Hole _____


Abandoned _____

Date

8/7 1919Payle Scout

Map No. K15 Sec. 35 Twp. 25 R. 8Well No. 17 FarmTidal & Southern Company

NORTH

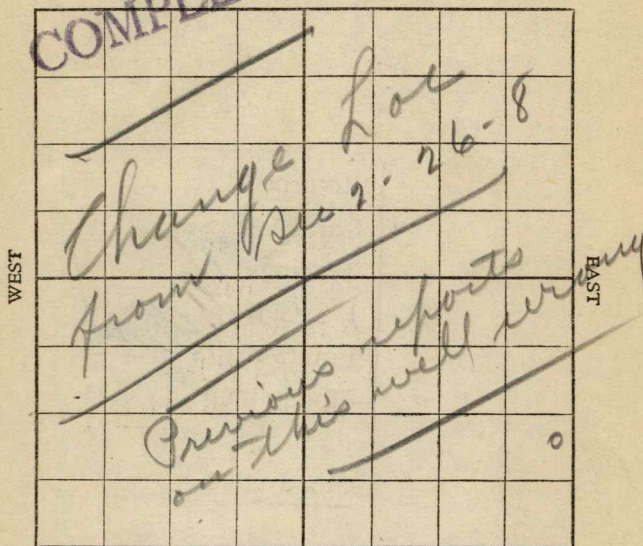

250 E

SOUTH

10205

Location

Rig up

Drilling and Remarks:

RECORD

Cased in Ft.

Sand 1326-1359

Gas

Oil

Total Depth 1377

PRODUCTION

1st 24 hrs. Nat.

1st 24 hrs. after shot

Gas Cu. Ft.

Dry Hole

Abandoned 1377

Date

8/20, 1919, Oyle Scout