
FORM 51 10M 2-49 PETROL KANSAS Pawnee

Section 24 Township 20 Range 16W

Well No. 3 Deckert

Company Stanolind et al

Pawnee Rock

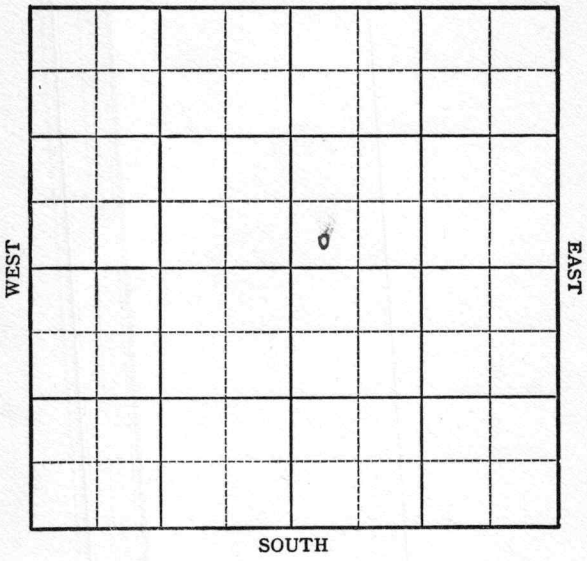

FORM 252-A
5M 10-48 PETROL

KANSAS - Pawnee **HOT FILE**

Sec. 24 Twp. 20 R. 16W

Well No. #3 Deckert Farm

Stanolind et al Company

Pawnee Rock Pool


_____ Ft. from N. Line

330' Ft. from S. Line

_____ Ft. from E. Line

330' Ft. from W. Line

SW NE

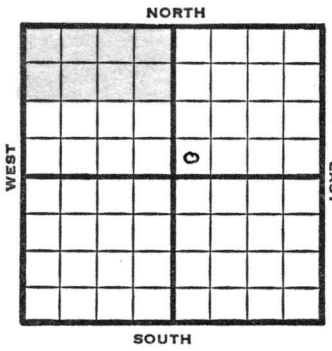

1949	Elev. 2109' REPORT
2/23	RUR
3/2	"
3/8	8"@ 1120' Drlg 3370'
3/16	Lansing 3529' Arb. 3807' TD 3854' 5 @ 3849'
3/23	Swb 21 bbls oil & 2½ W in 4 hrs.
3/30	Arb 3807' 5" @ 3849' Pump 100 oil & 40 W Pot. Gr. 39o TD 3854' **COMPLETED**

Form 26 200 Bks. 9-48 Petrol

Kansas

Pawnee Rock Pool

Map No. _____ Sec. 24 Twp. 20 R. 16W


Well No. 3 Deckert

Stanolind etal. Company

FIRST REPORT Contractor

SW NE

SECTION PLAT

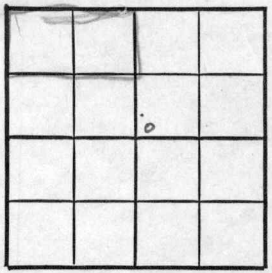

_____ Ft. from N. Line

330 Ft. from S. Line

_____ Ft. from E. Line

330 Ft. from W. Line

Pawnee County

Location _____

Rig up _____

Drilling and Remarks:

R U R

RECORD

Cased _____ in., _____ ft.

Sand _____

Gas _____

Oil _____

Total Depth _____

PRODUCTION

1st 24 hrs. Nat. _____

1st 24 hrs. after shot _____

Gas _____ Cu. Ft.

Dry Hole _____

Abandoned _____

Date

FEB 23 1949 19

S. J. LEWIS Scout

Form 26 200 Bks. 9-48 Petrol

Kansas

Pawnee Rock

Map No. 81 Sec. 24 Twp. 20 R. 16W

Well No. 3 Deckert "C"


Stanolind etal. Company

COMPLETE Contractor

SW NE

E.L.2109

SECTION PLAT

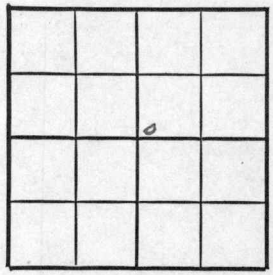

____ Ft. from N. Line

330 Ft. from S. Line

____ Ft. from E. Line

330 Ft. from W. Line

Pawnee County

Location

Rig up

Drilling and Remarks:

Cir + 3807

5' @ 3547

Pump 100 oil + 40 W

R.T.

39° Gr

RECORD

Cased ____ in., ____ ft.

Sand

Gas

Oil

Total Depth 3537

PRODUCTION

1st 24 hrs. Nat.

1st 24 hrs. after shot

Gas ____ Cu. Ft.

Dry Hole

Abandoned

Date

MAR 30 1949 19

S. J. LEWIS Scout