


Section 2 Township 25 Range 3E

Well No. #3 Mullenex *(Matrix)*

Company Crest Petroleum

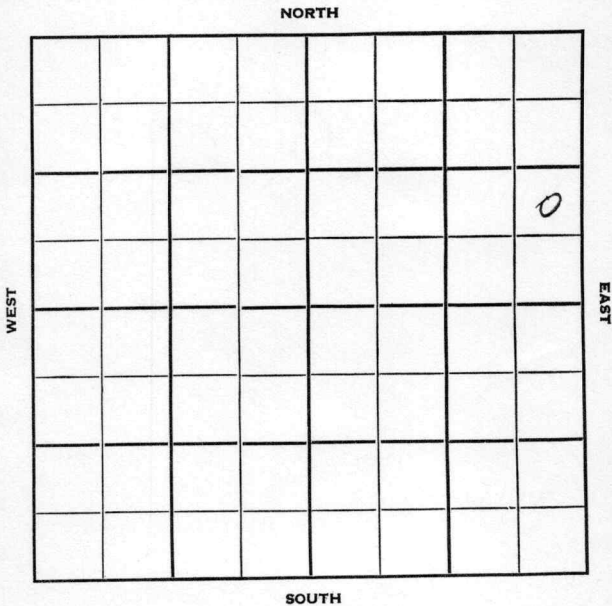

Butler

KANSAS ✓

Sec. 2 Twp. 25 R. 3E

Well No. #3 Mullenex Farm

Crest Petroleum Company

Contractor


_____ Ft. from N. Line

990' Ft. from S. Line

330' Ft. from E. Line

_____ Ft. from W. Line

NE SE NE

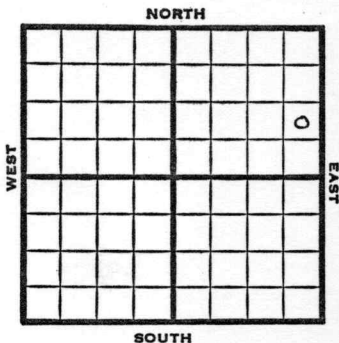

1951 Elev. 1341' REPORT

4/18

Location

6/6

Spud 4-24-51

Oil well TD 2724'

4" @ 2721' Miss 2720' TD 2724'

Comp. 30 BOPD 5 BW

COMPLETED

County Butler State Kansas

Sec. 2 (Bk. 25) (Sur. 3E) Map No.

Operator Crest Petroleum

Well No. 3 Farm Mullenex

Elev. 1341 Location NE SE NE

							0
COMPLETE							

990 Ft. From S Line NE

330 Ft. From E Line Quarter

Ist. Report

Completion JUN 6 1951

Remarks

Spudding Date 4-24-51

Drlg. Data Oil well TD 2724

4" @ 2721 Miss. 2720 TD 2724

Comp. 30 bopd 5 bw

J. E. TYRA