KANSAS

Pawnee


FORM 51 IOM 12-46 PETROL

Section 24 Township 20 Range 16-W

Well No. 1 Havins

Company W. P. Faulkner et al

Pawnee Rock Pool

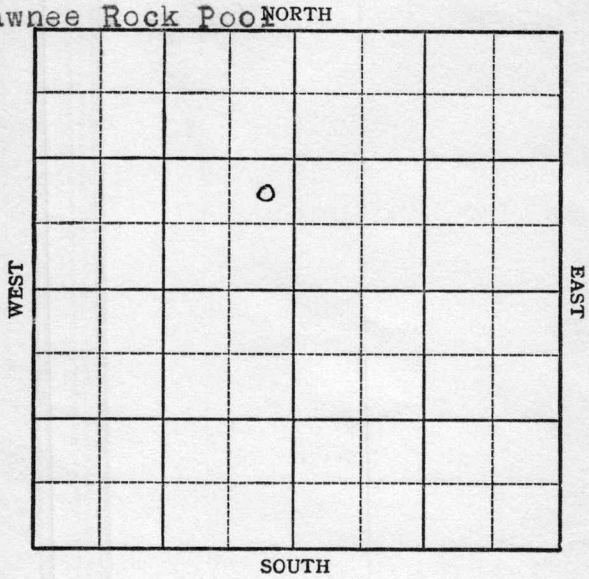

FORM 252-A
5M 9-47 PETROL

KANSAS Pawnee

Sec. 24 Twp. 20 R. 16W

Well No. #1 Havins Farm

W. P. Faulkner et al Company

Pawnee Rock


____ Ft. from N. Line

990 Ft. from S. Line

330 Ft. from E. Line

____ Ft. from W. Line

NE SE NW

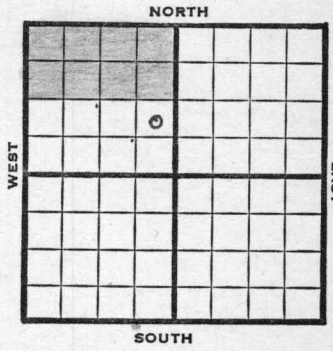

1947	Elev. 2096' REPORT
10/1	Location
10/8	Drlg. 100'
10/15	8" @ 1070' Drlg. 2725'
10/22	Lansing 3520' Drlg. 3705'
10/29	Arbuckle 3789' TD 3824' 5" @ 3822' RUST
11/5	"
11/12	"
11/19	"
11/25	"
12/5	Arbuckle 3789' T.D. 3824' 5" set 3822' Drilled cement to TD Acidized 500 gals. Flowed 30 bbls. oil per hour, no time. (Wire)

OVER

1947

12/10 Arb. 3789'
5" @ 3822'
500 acid.
Flow 600 pot.
38.7 Gr.
TD 3824'

COMPLETED

Form 26 200 Bks. 10-46 Petrol

Kansas

Pawnee Rock Pool

Map No. _____ Sec. 24 Twp. 20 R. 16W

Well No. 1 Havins


W. P. Faulkner etal. Company

FIRST REPORT

Contractor

NE SE NW

SECTION PLAT

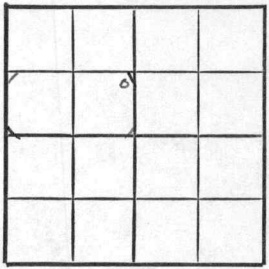

_____ Ft. from N. Line

990 Ft. from S. Line

330 Ft. from E. Line

_____ Ft. from W. Line

Pawnee County

Location x

Rig up _____

Drilling and Remarks:

RECORD

Cased _____ in., _____ ft.

Sand _____

Gas _____

Oil _____

Total Depth _____

PRODUCTION

1st 24 hrs. Nat. _____

1st 24 hrs. after shot _____

Gas _____ Cu. Ft.

Dry Hole _____

Abandoned _____

Date

OCT 1 1947

19 S. J. LEWIS Scout

Form 26 200 Bks. 10-46 Petrol

Pawnee Rock

Kansas

Map No. 81 Sec. 24 Twp. 20 R. 16W

Well No. 1 Havins


W. P. Faulkner etal. Company

COMPLETE Contractor

NE SE NW

E 42096.

SECTION PLAT

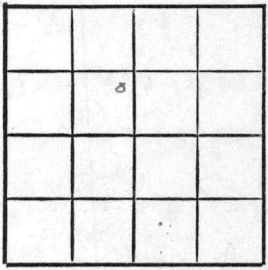

Ft. from N. Line

990 Ft. from S. Line

330 Ft. from E. Line

Ft. from W. Line

Pawnee County

Location

Rig up

Drilling and Remarks:

Ran 3789

5" @ 3822

300 sacks

Flow 600 BF

3823 Gr

RECORD

Cased in., ft.

Sand

Gas

Oil

Total Depth 3824

PRODUCTION

1st 24 hrs. Nat.

1st 24 hrs. after shot

Gas Cu. Ft.

Dry Hole

Abandoned

Date

DEC 10 1947 19

S. J. LEWIS Scout