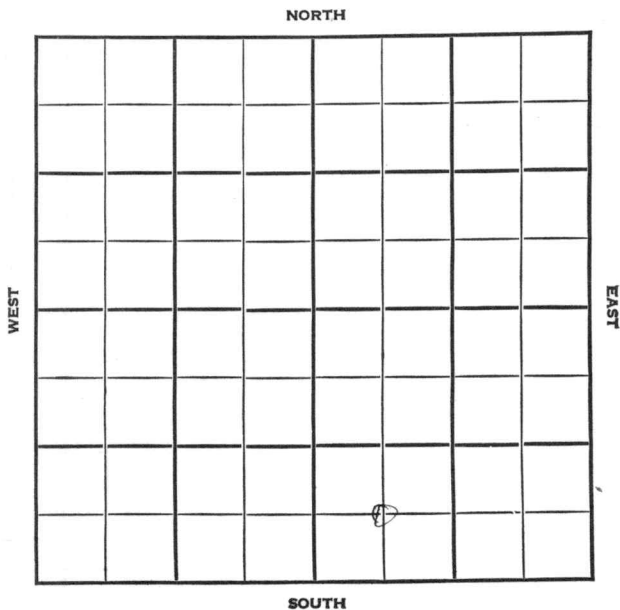


KANSAS

Section 24 Township 20 Range 16WWell No. #1 SiebertCompany Sunray

KANSAS

HOT FILE
Pawnee

Sec. 24 Twp. 20 R. 16-W

Well No. #1 Siebert Farm

Sunray Company

Pawnee Rock


Ft. from N. Line

330' Ft. from S. Line

Ft. from E. Line

660' Ft. from W. Line

C S L SW SE

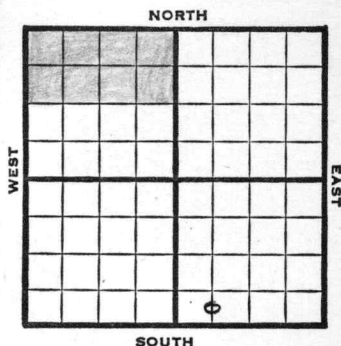

1947

Elev. 2070' REPORT

11/25

Location

12/3

Drlg. 917'

12/10

8" @ 1077'
Drlg. 2995'

12/30

Arb. 3786'
5" @ 3801'
1000 acid
Pump 100 Pot
39.0 Gr.
TD 3816½'

COMPLETED

Map No. _____ Sec. 24 Twp. 20 R. 16W


Well No. 1 Siebert

Sunray Company

FIRST REPORT Contractor

C S L SW SE

SECTION PLAT

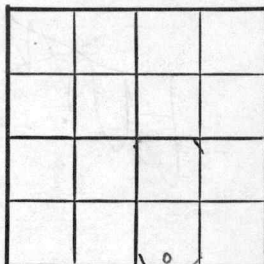

_____ Ft. from N. Line

330 Ft. from S. Line

_____ Ft. from E. Line

660 Ft. from W. Line

Pawnee County

Location X

Rig up _____

Drilling and Remarks:

RECORD

Cased _____ in., _____ ft.

Sand _____

Gas _____

Oil _____

Total Depth _____

PRODUCTION

1st 24 hrs. Nat. _____

1st 24 hrs. after shot _____

Gas _____ Cu. Ft.

Dry Hole _____

Abandoned _____

Date

NOV 25 1947

19

S. J. LEWIS

Scout

Kansas

Map No. 81 Sec. 24 Twp. 20 R. 16WWell No. 1 Siebert


Sunray

Company

COMPLETE

Contractor

C S L SW SE

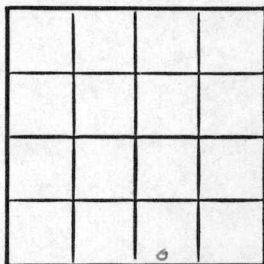E 12070
SECTION PLAT

_____ Ft. from N. Line

330 Ft. from S. Line

_____ Ft. from E. Line

660 Ft. from W. Line

Pawnee County

Location _____

Rig up _____

Drilling and Remarks:

*See #3786**5" @ 880'**1000 acid**Pump 100 Bbl**88 2/3'*

RECORD

Cased _____ in., _____ ft.

Sand _____

Gas _____

Oil _____


PRODUCTION

1st 24 hrs. Nat: _____

1st 24 hrs. after shot _____

Gas _____ Cu. Ft.

Dry Hole _____

Abandoned _____

Date

DEC 30 1947

19

S. J. LEWIS

Scout