

Butler  
25

3E

Section 3 Township \_\_\_\_\_ Range \_\_\_\_\_

Well No. 1 Joseph

Company R. J. Wixon

NORTH


WEST

EAST

0

SOUTH

Butler

KANSAS

SEC.	TWP.	R.
3	25	3 E ✓

WELL NO. \_\_\_\_\_

COMPANY # 1 Joseph FARM

CONTRACTOR R. J. Wixon


Potwin Pool

\_\_\_\_\_ Ft. from N. Line  
330

\_\_\_\_\_ Ft. from S. Line

\_\_\_\_\_ Ft. from E. Line

330 \_\_\_\_\_ Ft. from W. Line

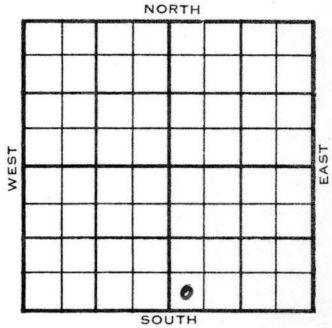

SW SW SE

	ELEVATION	REPORT
1953	1352'	

11/4

MICT

12/16

Spud 11-11-53  
Oil Well  
TD 2747'  
10" @ 1655'  
KC 2295'  
8" @ 2405'  
Cong 2720', Miss 2732'  
5" @ 2732'  
DC 2747',  
1000A  
Comp. 25 bopd

COMPLETED



