

Butler


KANSAS

FORM 51

Section 3 Township 25 Range 3E

Well No. #3 Joseph

Company Wixson et al

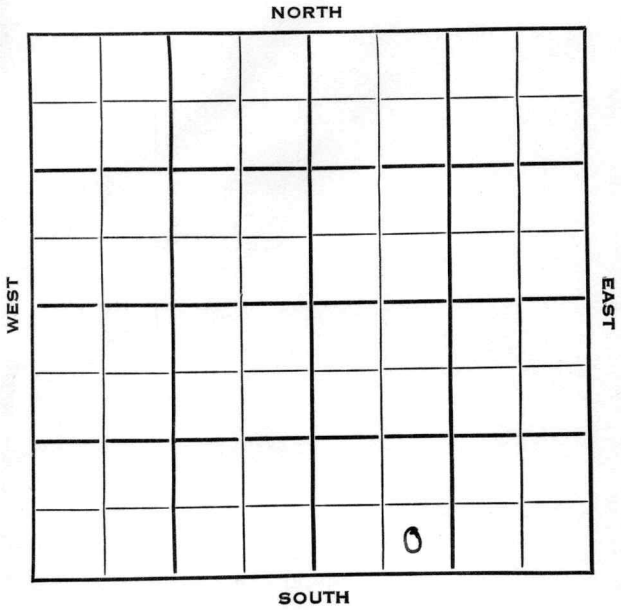

Butler

KANSAS

SEC.	TWP.	R.
3	25	3E ✓

WELL NO. _____

COMPANY #3 Joseph FARM

CONTRACTOR Wixson et al


Wixson

_____ Ft. from N. Line

330 _____ Ft. from S. Line

_____ Ft. from E. Line

990 _____ Ft. from W. Line

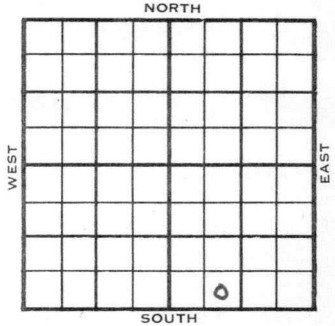

SE SW SE

	ELEVATION	REPORT
1954	1348'	
1/13	Spud 1-5-54 15" @ 99'	
2/17	Drlg 885' Spud 1-5-54 Oil well TD 2741 15" @ 99 10" @ 1675 Lans. 2020' 8" @ 2160 KC 2290 B KC 2385 7" @ 2425 TD 2741 Miss 2730 5" @ 2732 20/2410-16 1000 A CO to 2741 2000 A Comp. 25 BOPD	

COMPLETED

