
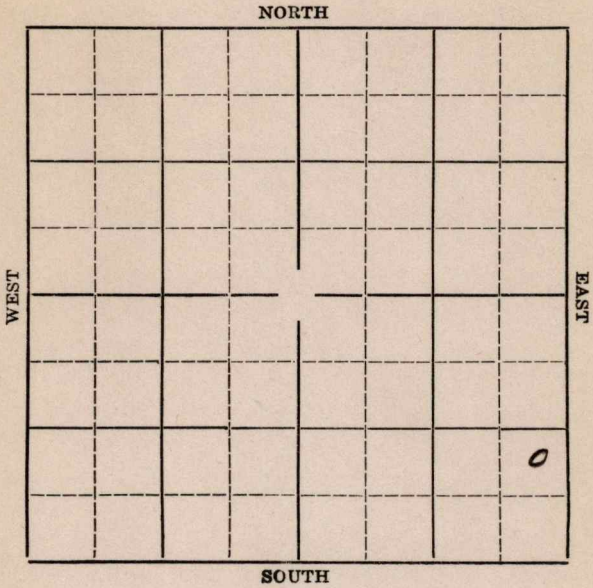


Section 36 Township 25 Range 8-EWell Number #1 BrydenCompany O.V. Paul

Sec. 36 Twp. 25 R. 8-E

Well No. 1 Bryden Farm
O. V. Rand or Paul-1CGS/ONL Company

 Ft. from N. Line
990 Ft. from S. Line
330 Ft. from E. Line
 Ft. from W. Line

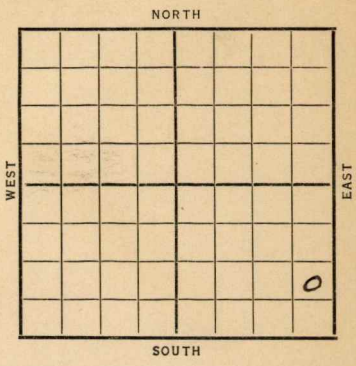

Date	REPORT
11/4	5" C 1260'
	Bart. 1265'
	T. D. 1272
	Bail 12 bbls. per hour
11/12----	
11/18	Bart. sd 1265 to 1272
	T. D. 1272 30 bbls.
	COMPLETED

Map No. 15 Sec. 36 Twp. 25 R. 8EWell No. 1 BrydenO. V. Paul. Company

Contractor

SECTION PLAT

			0

_____ Ft. from N. Line

990 Ft. from S. Line330 Ft. from E. Line

_____ Ft. from W. Line

FIRST REPORT

Location _____

Rig up _____

Drilling and Remarks:

5" @ 1260Barrel 1265TD 1272.tail 1288 1/2 per.

RECORD

Cased _____ in., _____ ft.

Sand _____

Gas _____

Oil _____

Total Depth _____

PRODUCTION

1st 24 hrs. Nat. _____

1st 24 hrs. after shot _____

Gas _____ Cu. Ft.

Dry Hole _____

Abandoned _____

Date

NOV 4 1936 19S. J. LEWIS Scout

Greenwood KANSASMap No. 15 Sec. 36 Twp. 25 R. 8EWell No. 1 Bryden.O. V. Paul.

Company

Contractor

SECTION PLAT

			0

1270 Ft. from N. Line990 Ft. from S. Line330 Ft. from E. Line

Ft. from W. Line

COMPLETED

Location _____

Rig up _____

Drilling and Remarks:

Bar & Sol 1265& 1272.30 & 1/2.

RECORD

Cased _____ in., _____ ft.

Sand _____

Gas _____

Oil _____

Total Depth 1272.

PRODUCTION

1st 24 hrs. Nat. _____

1st 24 hrs. after shot _____

Gas _____ Cu. Ft.

Dry Hole _____

Abandoned _____

Date

NOV 18 1936 19

S. J. LEWIS Scout