Pawnee County


FORM 51 10M 8-47

KANSAS

Section 24 Township 20 Range 16W

Well No. 2 Siebert

Company Sunray

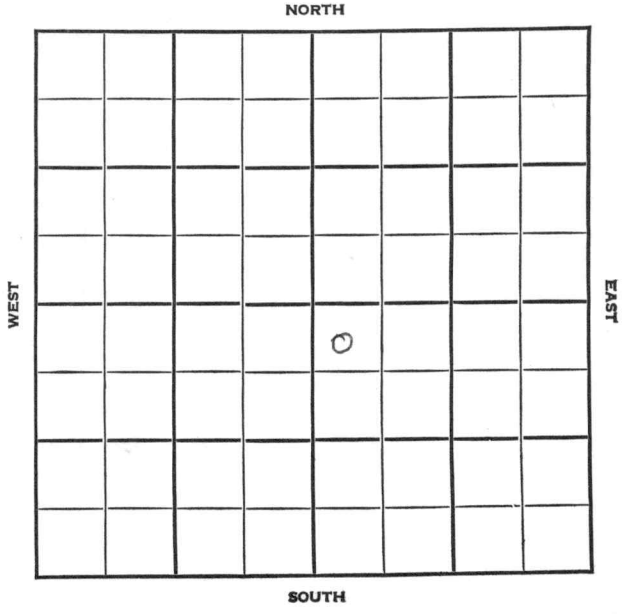

FORM 252-A
5M 9-47 PETROL

HOT FILE

Pawnee KANSAS

Sec. 24 Twp. 20 R. 16W

Well No. #2 Siebert Farm

Sunray Company

Pawnee Rock


330 Ft. from N. Line

Ft. from S. Line

Ft. from E. Line

330 Ft. from W. Line

NW SE

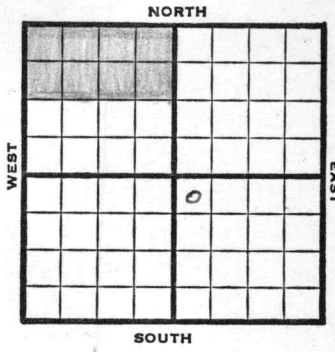

1947	Elev. 2100' **REPORT**
12/17	RUR
12/30	8" @ 1103' Anhydrite 1097' Drlg. 3100'
1948 1/7	Conglomerate 3796' Lansing 3510' Arbuckle3815' TD 3836' 5" @ 3826' RUST
1/14	**TD 3839'** **Flow 20 bbls oil PH 9 hrs**
1/21	Arb. 3815' 5" @ 3826' Pump 100 pot 39.0 Gr. TD 3839' Comp.

COMPLETED

Form 26 200 Bks. 10-46 Petrol

Kansas

Pawnee Rock

Map No. _____ Sec. 24 Twp. 20 R. 16W

Well No. 2 Siebert

Sunray Company

FIRST REPORT Contractor

NW SE

330 Ft. from N. Line


_____ Ft. from S. Line

_____ Ft. from E. Line

330 Ft. from W. Line

Pawnee County

SECTION PLAT

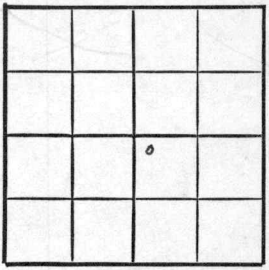

Location _____

Rig up _____

Drilling and Remarks:

R U R

RECORD

Cased _____ in., _____ ft.

Sand _____

Gas _____

Oil _____

Total Depth _____

PRODUCTION

1st 24 hrs. Nat. _____

1st 24 hrs. after shot _____

Gas _____ Cu. Ft.

Dry Hole _____

Abandoned _____

Date

DEC 17 1947 19 S. J. LEWIS Scout

Form 26 200 Bks. 10-46 Petrol

Kansas

Pawnee Rock Pool

Map No. 81 Sec. 24 Twp. 20 R. 16W

Well No. 2 Siebert


Sunray Company

COMPLETE Contractor

NW SE

E1.2100

SECTION PLAT

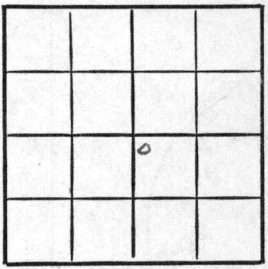

330 Ft. from N. Line

Ft. from S. Line

Ft. from E. Line

330 Ft. from W. Line

Pawnee County

Location

Rig up

Drilling and Remarks:

Cr 3875'
5' @ 3826

Pump 100 BF

89-4w

RECORD

Cased in., ft.

Sand

Gas

Oil ✓

Total Depth 3889

PRODUCTION

1st 24 hrs. Nat.

1st 24 hrs. after shot

Gas Cu. Ft.

Dry Hole

Abandoned

Date

JAN 21 1948 19

S. J. LEWIS Scout