
FORM 51 5M BRIX

KANSAS Butler County

Section 3 Township 25 Range 3E

Well No. #1 Joseph

Company E. H. Adair

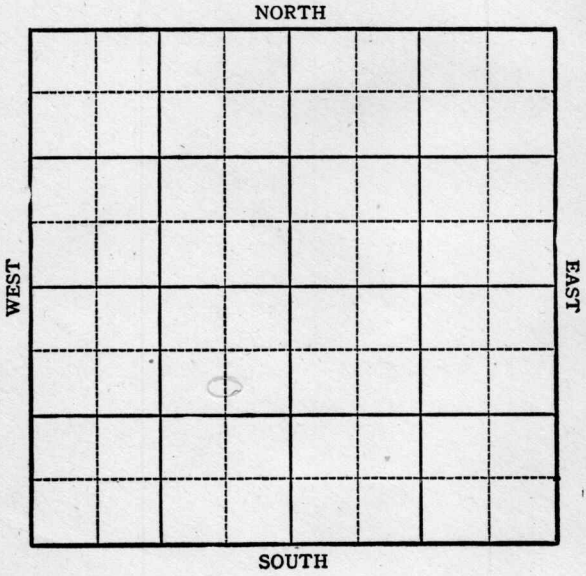

FORM 252-A
5M 9-44 PETROL

KANSAS Butler County

Sec. 3 Twp. 25 R. 3E

Well No. #1 Joseph Farm

E. H. Adair Company

Miscellaneous


990 Ft. from N. Line

Ft. from S. Line

660 Ft. from E. Line

Ft. from W. Line

CSL NE SW

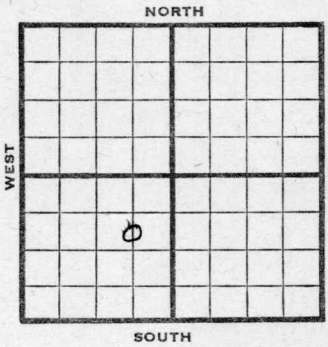

1944	REPORT
11/15	Cable
11/24	"
11/29	15" @ 80 Drlg. 2080
12/6	12" @ 960 10" @ 1690' Drlg. 1900
12/14	Drlg. 2350'
12/20	Miss 2768 TD 2710'
	ABANDONED

FORM 56 200 BKS, 1-44 PETROL

Pool Name Miscellaneous

Map No. 13 Sec. 3 Twp. 25 R. 3E

Well No. 1 Joseph

E. H. Adair Company

FIRST REPORT Contractor

C S L NE SW


990 Ft. from N. Line

Ft. from S. Line

660 Ft. from E. Line

Ft. from W. Line

SECTION PLAT

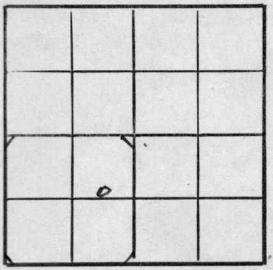

Butler

Location

Rig up

Drilling and Remarks:

cable

RECORD

Cased in., ft.

Sand

Gas

Oil

Total Depth

PRODUCTION

1st 24 hrs. Nat.

1st 24 hrs. after shot

Gas Cu. Ft.

Dry Hole

Abandoned

Date

NOV 15 1944 19

S. J. LEWIS Scout

FORM 26 200 BKS 1-44 PETROL

Pool Name Miscellaneous

Map No. 13 Sec. 3 Twp. 25 R. 3E

Well No. 1 Joseph

E.H. Adair Company

ABANDONED Contractor

C S L NE SW


990 Ft. from N. Line

Ft. from S. Line

660 Ft. from E. Line

Ft. from W. Line

SECTION PLAT

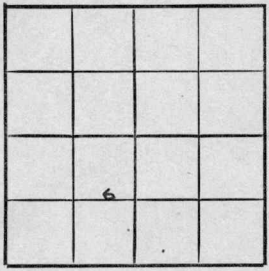

Butler

Location

Rig up

Drilling and Remarks:

Miss 2768

RECORD

Cased in., ft.

Sand

Gas

Oil

Total Depth 2210

PRODUCTION

1st 24 hrs. Nat.

1st 24 hrs. after shot

Gas Cu. Ft.

Dry Hole

Abandoned

Date

DEC 2 0 1944 19

S. J. LEWIS Scout