


Greenwood
Form 51-5M-11-31-Palace
Map No. **KANSAS** Sec. 36 Twp. 25 R. 8E
Well No. 1-Braden Farm
O.V. Paul, et al Company

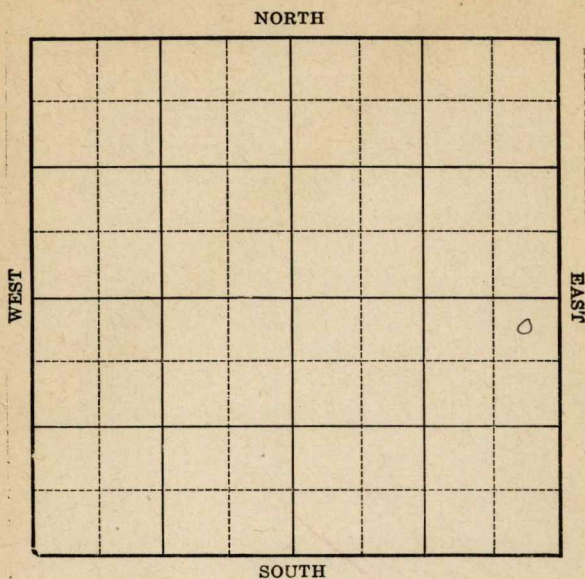

Location

Drilling Remarks

Rig Up

Drilling Remarks

RECORD

Cased in. ft.

Sand

Gas

Oil

Total Depth

PRODUCTION

1st 24 hrs. Nat.

1st 24 hrs. after shot

Gas cu. ft.

Dry Hole

Abandoned

Map No. **KANSAS** Sec. 36 Twp. 25 R. 8^E


Well No. 1- Bryden Farm
O. V. Paul et al Company

250 Ft. from N. Line

_____ Ft. from S. Line

250 Ft. from E. Line

_____ Ft. from W. Line

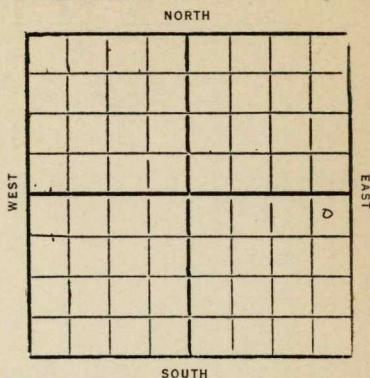

Date

REPORT

8/30	Bk. mach
9/7	Opdg 150'
9/14	Opdg + SD for water
9/21	—
9/30	—
10/5	—
10/12	—
10/19	—
10/26	—
11/2	—
11/9	—
11/16	—
11/23	Opdg 200'
11/30	Opdg 500'
12/7	" 840'
12/14	SD 855'
12/21	—
12/28	—
1933	—
1/4	—
1/11	—
1/18	Opdg 1140'

1/2.5 drlg 1250'

2/1- 6"-1252

small shaw 1264

drlg ahead

2/8 Cased 6"-1252

Land 1255-61½

5 bbl shaw

HFW 1261-70

T.D. 1270

Abandoned

Greenwood

15 KANSAS

Map No. _____ Sec. 36 Twp. 75 R. 8^E

Well No. 1 Bryden

O. V. Paul et al Company

Contractor

FIRST REPORTS

SECTION PLAT

750 Ft. from N. Line

_____ Ft. from S. Line

750 Ft. from E. Line

_____ Ft. from W. Line

			0

Location _____

Rig up _____

Drilling and Remarks:

Rigging up
machine.

RECORD

Cased _____ in., _____ ft.

Sand _____

Gas _____

Oil _____

Total Depth _____

PRODUCTION

1st 24 hrs. Nat. _____

1st 24 hrs. after shot _____

Gas _____ Cu. Ft.

Dry Hole _____

Abandoned _____

Date

AUG 3 1 1932

192

CHAS. L. SHERWOOD

Scout

Greenwood

E

Map No. 15 KANSAS Sec. 36 Twp. 25 R. 8

Well No. 1 Bryden
O. V. Paul et al Company

Contractor

COMPLETED

SECTION PLAT

250 Ft. from N. Line

Ft. from S. Line

250 Ft. from E. Line

Ft. from W. Line

			0

ABANDONED

Location

Rig up

Drilling and Remarks:

Land 1255-61 1/2
5 hrs show
HFW 1261-70

RECORD

Cased 6 in., 1252 ft.

Sand

Gas

Oil

Total Depth 1270

PRODUCTION

1st 24 hrs. Nat.

1st 24 hrs. after shot

Gas Cu. Ft.

Dry Hole ✓

Abandoned ✓

Date

FEB 8 1933

192

CHAS. L. SHERWOOD

Scout