


Section 6 Township 25 Range 3E

Well No. #1 Ullmer

Company Lindas Oil

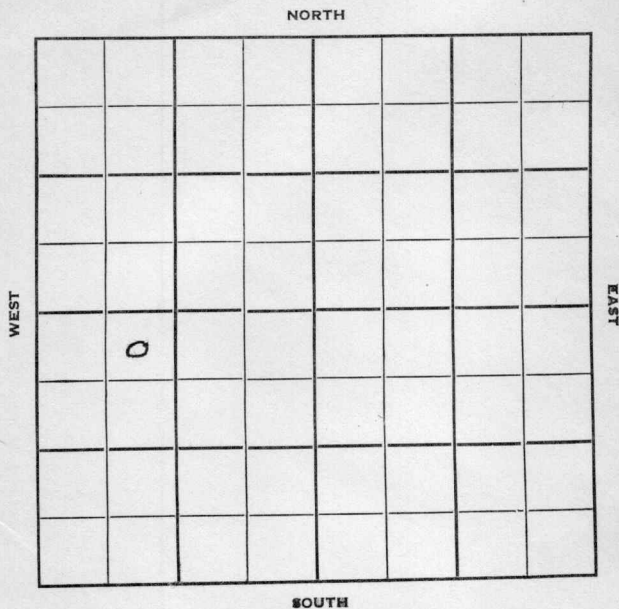

Butler

KANSAS ✓

Sec. 6 Twp. 25 R. 3E

Well No. #1 Ullmer Farm

Lindas Oil

Company

Contractor

Wildcat

330

Ft. from N. Line


Ft. from S. Line

Ft. from E. Line

990

Ft. from W. Line

NE NW SW

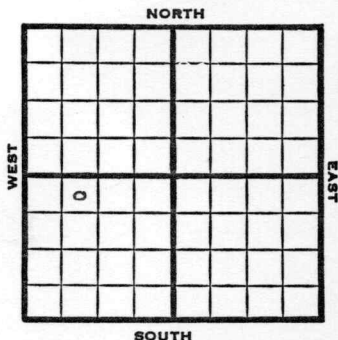

1952

Elev. 1348' REPORT

10/15

Spud 10-13-52
10" @ 97' WOC

10/29

Spud 10-13-52
D&A TD 2821'
10" @ 97'
Lans. 2086'
B KC 2499
TD 2821' D&A

KC 2343
Miss. 2785

ABANDONED

County Butler State KansasSec. 6 (Blk.
Twp.) 2 5 (Sur.
Rge.) 3E Map No.Operator Lindas OilWell No. 1 Farm UllmerElev. Location NE NW SW

330 Ft. From N Line SW990 Ft. From W Line Quarter1st. Report OCT 15 1952

Completion

Remarks

Spudding Date 10-13-52Drlg. Data Wildcat10" @ 97 WOC

J. G. McGEHEE

J. G. McGEHEE