

Map No. _____ Sec. 26 Twp. 20 R. 0
Well No. 2-Bryden Farm _____
Mid-Kansas Company _____

NORTH

WEST

EAST

SOUTH

Location_____

Drilling Remarks:

Rig Up-----

Drilling Remarks:

RECORD

Cased----- in.-----ft.

Sand -----

Gas _____

Oil _____

Total Depth_____

PRODUCTION

1st 24 hrs. Nat.-----

1st 24 hrs. after shot-----

Gas-----cu. ft


Dry Hole_____

Abandoned -----

Map No. *K15* Sec. *36* Twp *25* R. *8*
 Well No. *2 Bryden* Farm
Mid-Kans Oil Company

NORTH

WEST

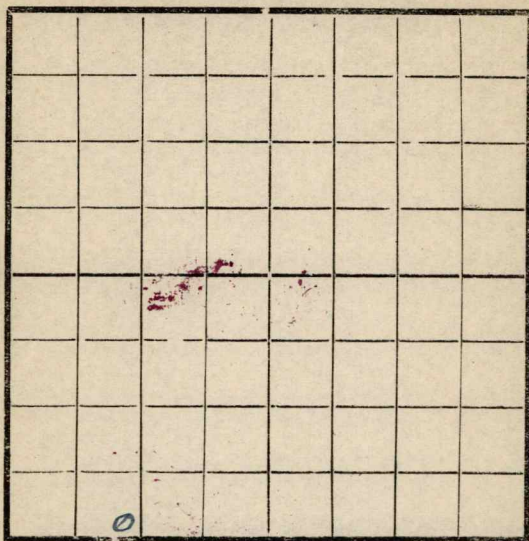

EAST

SOUTH

Location -----
 Rig Up -----
 Drilling and remarks

*300' N } D. W.
 1020' E } Cot.*

RECORD

Cased ----- in. ----- Ft.
 Sand -----
 Gas -----
 Oil -----
 Total Depth -----

PRODUCTION

1st 24 hrs. Nat. -----
 1st 24 hrs. after shot -----
 Gas ----- Cu. Ft.
 Dry Hole -----
 Abandoned -----

Date

-----, 191----- Scout

Map No. _____ Sec. 36 Twp. 25 R. 8
 Well No. 2 Bryden Farm _____
Mid Kansas Company _____

NORTH

WEST

FIRST REPORT

EAST

SOUTH

Location _____
 Rig Up _____
 Drilling and remarks

RECORD

Cased _____ in. _____ Ft.
 Sand _____
 Gas _____
 Oil _____
 Total Depth _____

PRODUCTION

1st 24 hrs. Nat. _____
 1st 24 hrs. after shot _____
 Gas _____ Cu. Ft.
 Dry Hole _____
 Abandoned _____

Date

11, 1917 Pyle Scout


200

15

Map No. _____ Sec. 36 Twp. 25 R. 8
 Well No. 2 Bryden Farm _____
Mid Kansas Company _____

NORTH

WEST

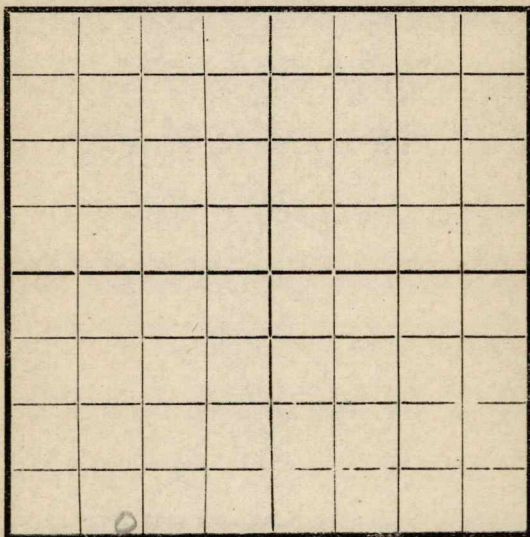

EAST

SOUTH

Location _____

Rig Up _____

Drilling and remarks

725'

RECORD

Cased _____ in _____ Ft.

Sand _____

Gas _____

Oil _____

Total Depth _____

PRODUCTION

1st 24 hrs. Nat. _____

1st 24 hrs. after shot _____

Gas _____ Cu. Ft.

Dry Hole _____

Abandoned _____

Date

11/23, 1917 Pyle Scout

Map No. _____ Sec. 36 Twp. 25 R. 8


Well No. 2 Bryden Farm

Mid Kan Company

NORTH

WEST

EAST

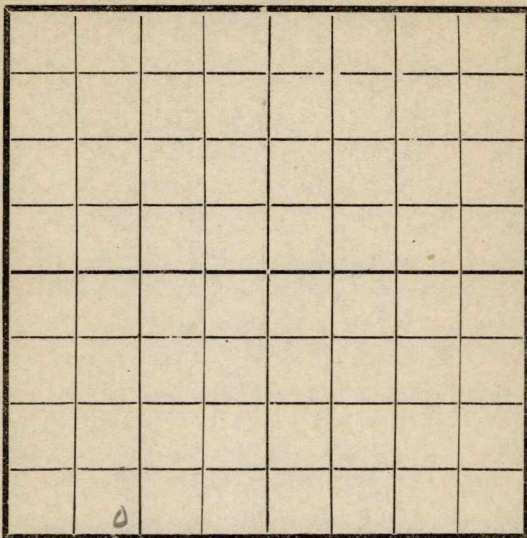

SOUTH

Location _____

Rig Up _____

Drilling and remarks

1250'

RECORD

Cased _____ in _____ Ft.

Sand _____

Gas _____

Oil _____

Total Depth _____

PRODUCTION

1st 24 hrs. Nat. _____

1st 24 hrs. after shot _____

Gas _____ Cu. Ft.

Dry Hole _____

Abandoned _____

Date

11/29, 1917


G. E.

Scout

Map No. _____ Sec. 36 Twp. 25 R. 8Well No. 2 Bryden Farm _____
Mid - Kansas Company _____

NORTH

WEST

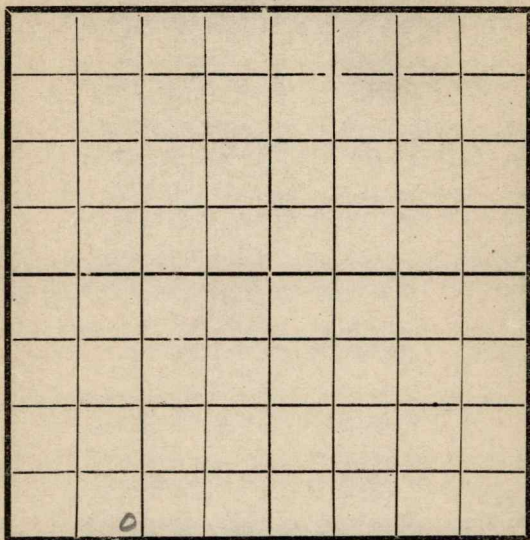

EAST

SOUTH

Location _____

Rig Up _____

Drilling and remarks

RECORD

Cased _____ in _____ Ft.

Sand _____

Gas _____

Oil _____

Total Depth _____

PRODUCTION

1st 24 hrs. Nat. _____

1st 24 hrs. after shot _____

Gas _____ Cu. Ft.

Dry Hole _____

Abandoned _____


Date

12/5, 1917 Pyle Scout

Map No. _____ Sec. 36 Twp. 25 R. 8Well No. 2 Bryden Farm _____Mid-Kano Company _____

NORTH

WEST

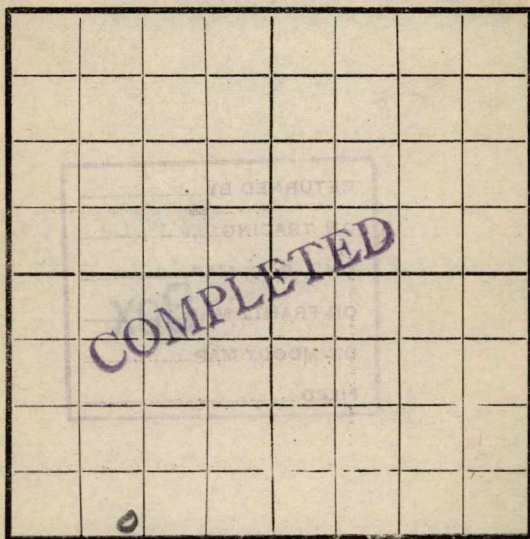

EAST

SOUTH

Location _____

Rig Up _____

Drilling and remarks _____

RECORD

Cased _____ in. _____ Ft.

Sand 2347-2385

Gas _____

Oil _____

Total Depth _____

PRODUCTION

1st 24 hrs. Nat. 150 bbl

1st 24 hrs. after shot _____

Gas _____ Cu. Ft.

Dry Hole _____

Abandoned _____


Date

12/28, 1917 Pyle Scout

Map No. 115 Sec. 36 Twp. 25 R. 8Well No. 2 Bryden FarmMid Kansas Company

NORTH

WEST

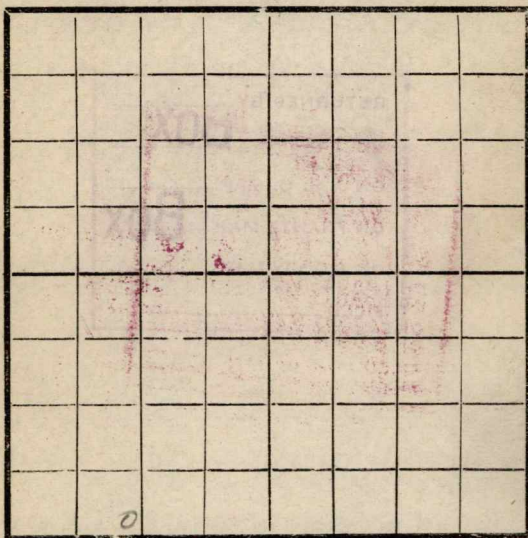

EAST

SOUTH

Location -----

Rig Up -----

Drilling and remarks

cleaning
out. made
100 bbl. flow
in one hr.
Friday night

RECORD

Cased ----- in. ----- Ft.

Sand -----

Gas -----

Oil -----

Total Depth -----

PRODUCTION

1st 24 hrs. Nat. -----

1st 24 hrs. after shot -----

Gas ----- Cu. Ft.

Dry Hole -----

Abandoned -----

Date

1918

Pyle

Scout