Form 51—10M—8-19—CroMac

Map No. K-15 Sec. 36 Twp. 23 R. 8E

Well No. 4 Brydon Farm

Mid-Kansas Oil Company

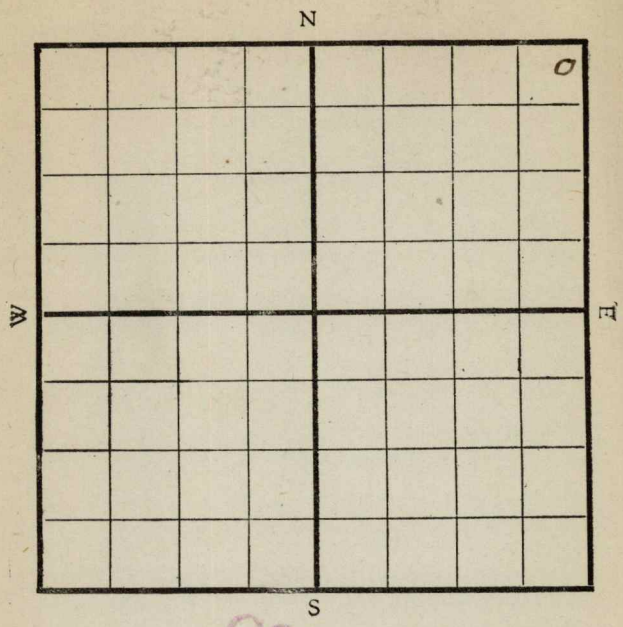

COMPLETED

Location

Drilling Remarks:

Rig Up

Drilling Remarks:

RECORD

Cased ____ in. ____ ft.

Sand

Gas

Oil

Total Depth

PRODUCTION

1st 24 hrs. Nat.

1st 24 hrs. after shot

Gas ____ cu. ft.

Dry Hole

Abandoned

Form 252A—6M-11-19-CroMac.

Map No. K Sec. 36 Twp. 25 R. 8

Well No. 4 Bryden Farm

Tidal & Gt. Bo. Company

Mid-Kansas

200 Ft. from N. Line

Ft. from S. Line

200 Ft. from E. Line

Ft. from W. Line

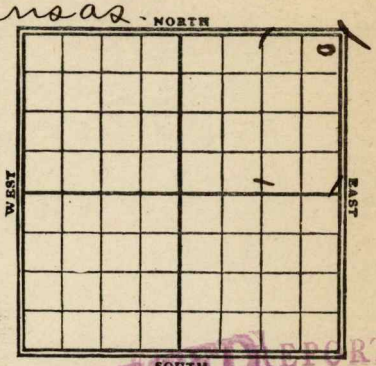

COMPLETED REPORT

	REPORT
7/2	Rig
10	—
22	200
28	Dlg 850'
8/6	— 900
8/13	Dlg @ 2200'
8/21	Dl @ 2335
8/27	2335-47-2417-100/100

Form 26—1M—4-19—Mid-West

Map No. K15 Sec. 36 Twp. 25 R. 8

Well No. 4 Bryden

Mid-Kansas Oil Company

Contractor

SECTION PLAT

200 Ft. from N. Line

Ft. from S. Line

200 Ft. from E. Line

Ft. from W. Line

FIRST REPORT

Location

Rig up

Drilling and Remarks:

RECORD

Cased in., ft.

Sand

Gas

Oil

Total Depth

PRODUCTION

1st 24 hrs. Nat.

1st 24 hrs. after shot

Gas Cu. Ft.

Dry Hole

Abandoned

Date

7/2 1920

Pyle Scout

Our map shows
Mid Kans Oil Co.
owns the
East 80 of ne 4
+ Sidel Sp. Sons
owns W2 of ne 4.
Please check
+ advise.

Returned
Cards
Tracing
J. S. C. map
Frantz map
Moody map
Frantz plat book
Moody plat book

Form 26—1M—4-19—Mid-West

Map No. K15 Sec. 36 Twp. 25 R. 8

Well No. 4 Bryden

Mid-Kansas Company

Contractor

SECTION PLAT

200 Ft. from N. Line

Ft. from S. Line

200 Ft. from E. Line

Ft. from W. Line

COMPLETED

Location

Rig up

Drilling and Remarks:

Shot 100 qts

RECORD

Cased in., ft.

Sand 2335-47

Gas

Oil

Total Depth 2417

PRODUCTION

1st 24 hrs. Nat.

1st 24 hrs. after shot 100 B

Gas Cu. Ft.

Dry Hole

Abandoned

Date

7/27 1920.

Pyle Scout