

K15


State ----- County -----

Sec. 36 Twp. 25 N-S; Rge. 8 E-W

Well No. 5 Bryden Farm

Mid-Kansas Oil Company

NORTH

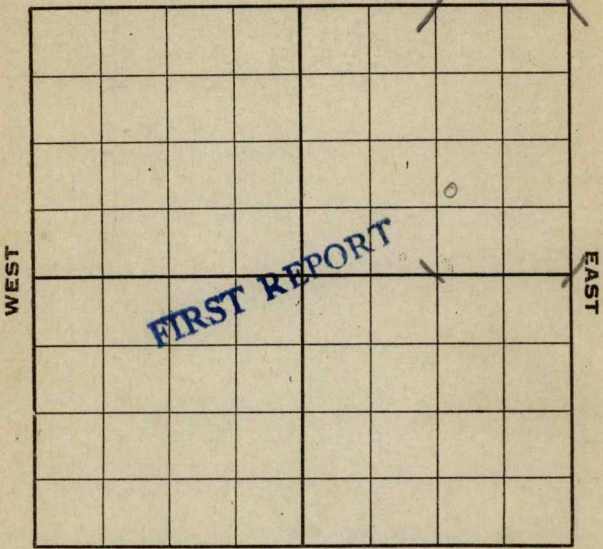

7605

SOUTH

1120 E

Location ----- Cased ----- in. ----- ft.

Rig up ----- Mach. ----- Productive Horizons From ----- To -----

Drilling at ----- Spud -----

Fishing at -----

U. R. to -----

S. D. at -----

Natural production ----- Bbls. per ----- hours

Pumping ----- Gas ----- Cu. ft. per 24 hours

Gauge press. ----- lbs. Total depth -----

Were samples collected -----

Remarks:

8.3.20

Pyle

Map No. K15 Sec. 36 Twp. 25 R. 8

Well No. 5 Bryden

Mid-Kansas Oil Company

Contractor

SECTION PLAT

			1
			0

----- Ft. from N. Line

760 Ft. from S. Line

1120 Ft. from E. Line

----- Ft. from W. Line

COMPLETED

Location -----

Rig up -----

Drilling and Remarks:

Shot 30 gts

RECORD

Cased ----- in., ----- ft.

Sand 1275-8.5

Gas -----

Oil -----

Total Depth -----

PRODUCTION

1st 24 hrs. Nat. -----

1st 24 hrs. after shot 40B

Gas ----- Cu. Ft.

Dry Hole -----

Abandoned -----

Date

8/27 19120

Pyle

Scout