


Section 19 Township 25 Range 2E

Well No. 1 Good

Company Francis Raymond

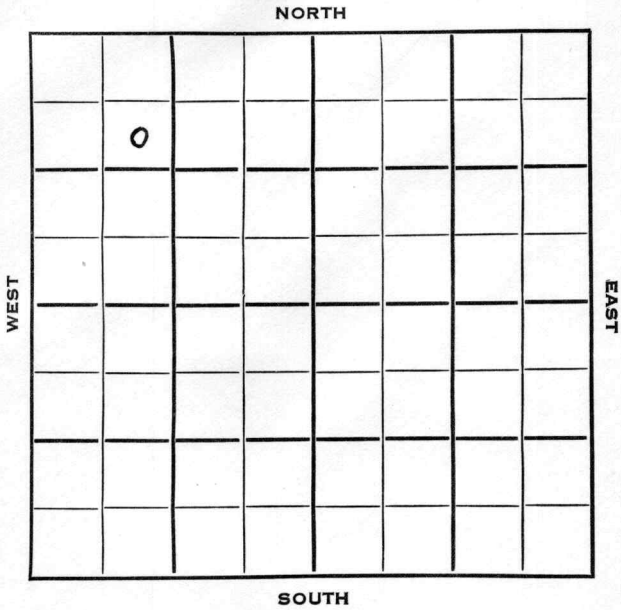

Sedgwick

KANSAS

SEC.	TWP.	R.
19	25	2E

WELL NO.

#1 Good

FARM

COMPANY

Francis Raymond

CONTRACTOR

Salina Drlg.

N. Kuske Pool

990	Ft. from N. Line	WEST NORTH SOUTH EAST
	Ft. from S. Line	
	Ft. from E. Line	
990	Ft. from W. Line	
SE NW NW		

1954	ELEVATION	REPORT
	1413'	

1/6	Location
1/20	Spud 1-6-54 D&A TD 3068' 8" @ 166' KC 2530', B KC 2714', Burgess 3025', Miss 3033' TD 3068' D&A
ABANDONED	

County **Sedgwick** State **Kansas**

Sec. 19 (Blk.) 25 (Sur.) 2E Map No.

Operator **Francis Raymond**

Well No. **1** Farm **Good**

Elev.	Location	SE	NW	NW

0

FIRST REPORT

990 Ft. From N Line NW

990 Ft. From **V** Line Quarter

1st. Report JAN 6 1954

Completion

Remarks

Salina Drlg. - Contr.


Spudding Date _____

Drig. Data N. Kuske Pool

Location

J. G. McGEHEE

County Sedgwick State Kansas
 Sec. 19 (Blk. 25 (Sur. 2E (Rge. 2E Map No.)
 Operator Francis Raymond
 Well No. 1 Farm Good
 Elev. 1413 Location SE NW NW

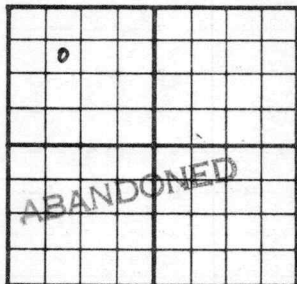

990 Ft. From N Line NW
990 Ft. From W Line Quarter
 1st. Report
 Completion JAN 20 1954
 Remarks N. Kuske Pool
Salina Drlg. - Contr.
 Spudding Date 1-6-54

Drlg. Data D & A TD 3 068
8" @ 166 KC 2530 B KC 2714
Burgess 3025 Miss. 3033 TD 3068
D & A