


DX 78-1 Pawnee

KANSAS

Section 26 Township 20 Range 16W

Well No. 1 Clutter

Company D. R. Lauck

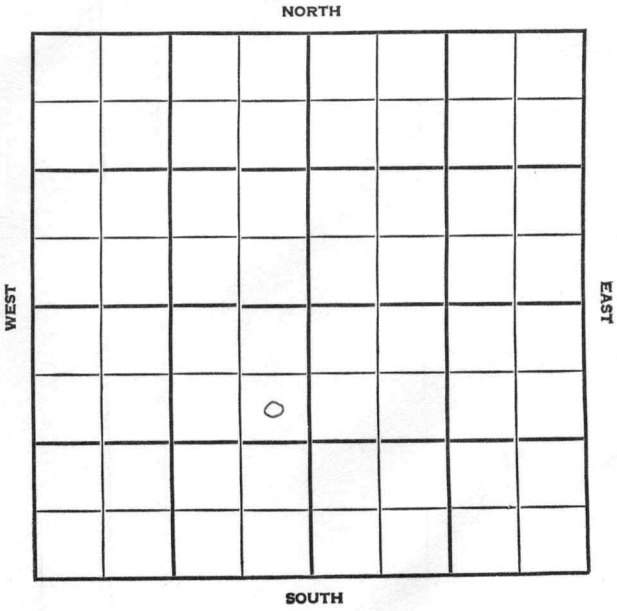

Pawnee		KANSAS
SEC.	TWP.	R.
26	20	16 W
WELL NO.		
# 1 Clutter		FARM
COMPANY		
D. R. Lauck		
CONTRACTOR		

Co. tools


Pawnee Rock Pool

990 _____ Ft. from N. Line

_____ Ft. from S. Line

330 _____ Ft. from E. Line

_____ Ft. from W. Line

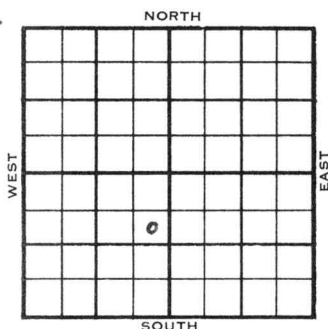

SE NE SW

1955	ELEVATION	REPORT
4/27	Location	
6/15	Comm 4/28/55	
	85/8" @ 1022/425, DST 3747-51, gas in 3 min. open 45 min, Rec. 240' gassy oil 1040/20" 5½" @3748 GO to 3751 DD 3755, DD 3759, S/20 bo 110 bw 8 hr. S/8½ bo 3½ bw 9 hr. P/166 bopd 12%	
	Tops:	Depth Datum
	Anh.	1010
	H.	3354 1337
	BL.	3437 1420
	L.	3448 1431
	B.K.C.	3657 1640
	S.	3732 1715
	A.	3747 1730
	TD.	3751
	COMPLETED	

County Pawnee State Kansas
Sec. 26 (Blk.) 20 (Sur.) 16W Map No.
Operator D. R. Lauck
Well No. 1 Farm Clutter
Elev. _____ Location SE NE SW

FIRST REPORT

990 Ft. From N Line SW
330 Ft. From E Line Quarter
1st. Report APR 27 1955
Completion _____
Remarks _____
Co. tools
Spudding Date _____

Drlg. Data Pawnee Rock Pool
Location

K-14

FABEN GILSTRAP

County Pawnee Elev. 2017Sec. 26 Twp. 20 Rge. 16WCompany D. R. LauckFarm Name Clutter No. 1

TOPS	DEPTH	LOG	DATUM	Loc. in Sec.
Anh.	1010			SE NE SW
T.P.				
H.	3354		1337	
Tr.				
Dg.				
Bl.	3437		1420	
L.	3448		1431	Geol.
K.C.				Contr.
B.K.C.	3657		1640	
Ce.				
C.				
M.				
M.				Pool
K.				Pawnee Rock
Mz.				
Me.				
V.				
S.	3732		1715	
S.				
A.	3747		1730	
R.				
Pe.				
G.				
T.D.	3751			

Date Comm. 4-28-55

JUN 15 1955

8 5/8" @ 1022/425 DST 3747-51 gas in

3 min. open 45 min. Rec. 240' gassy oil

1040/20" 5 1/2" @ 3748 CO to 3751

DD 3755 DD 3759 S/ 20 bo 110 bw

8 hr. S/ 8 1/2 bo 3 1/2 bw 9 hr.

P/ 166 bopd 12% bsw Comp. 166 bopd 12%