

WEST

EAST

SOUTH

0

Sedgwick

KANSAS

Sec. 19 Twp. 25 R. 2E

Well No. #1 Nickles Farm

C.L. Carlock Company

Wildcat. Contractor


 Ft. from N. Line

330 Ft. from S. Line

 Ft. from E. Line

330 Ft. from W. Line

SW SW SE

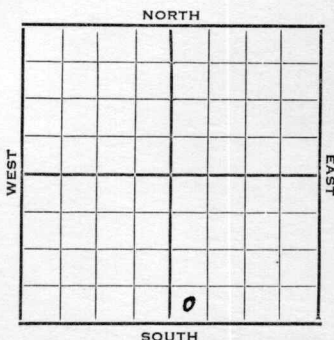

1953 Elev. 1437' REPORT

7/8 Loc.
9/2 Oil Well
TD 3010'
Lans 2362, KC 2540, B KC 2720', Burgess
3004
TD 3010'
5" @ 3007'
CO to 3010'
FU 160' fluid ph
P/ 20 bo 6 bwpd
Comp. 20 bopd 40 bw.

COMPLETED

County Sedewick State Kansas

Sec. 19 (Blk. Twp.) 25 (Sur. Rge.) 2E Map No.

Operator C. L. Carlock

Well No. 1 Farm Nickles

Elev.	Location	SW	SW	SE
-------	----------	----	----	----

FIRST REPORT

330 Ft. From S Line SE

330 Ft. From W Line Quarter

1st. Report JUL 8 1953

Completion

Remarks

Spudding Date

Drlg. Data Wildcat

Location

J. G. McGEHEE

County Sedgwick State Kansas

Sec.	19	(Blk.) (Twp.)	25	(Sur.) (Rge.)	2E	Map No.
------	----	------------------	----	------------------	----	---------

Operator C. L. Carlock

Well No. 1 Farm Nickles

Elev.	1437	Location	SW SW SE
-------	------	----------	----------

COMPLETE

0

330 Ft. From S Line SE

330 Ft. From W Line Quarter

1st. Report 250

Completion _____ 1953

Remarks	Wildcat
---------	---------

Spudding Date _____

Drig. Data Oil well TD 3010

Lans. 2362 KC 2540 B KC 2720

Burgess 3004 TD 3010 5" @ 3007

CO to 3010 FU 160' fluid ph

P/ 20 bo 6 bwpd Comp. 20 bopd 40 bw