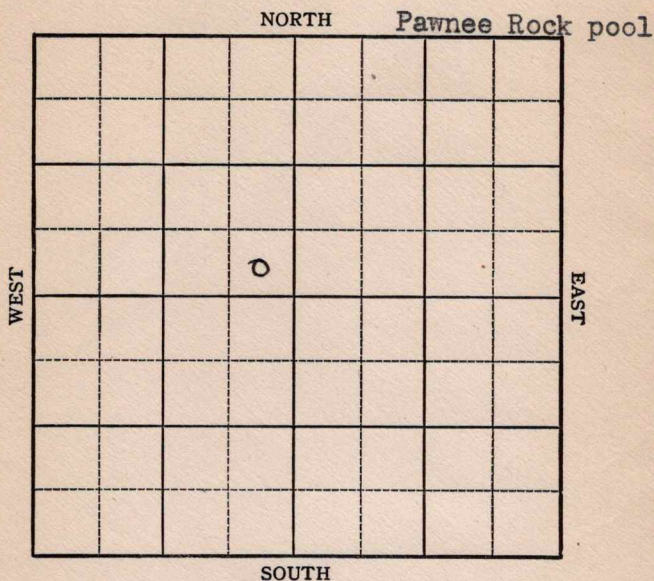


KANSAS

Pawnee Co.

Section 23 Township 20 Range 16WWell No. #1 Dirks "B"Company Vickers

Pawnee

Sec. 23 Twp. 20 R. 16W

Well No. #1 Dirks "B" Farm

Vickers

Company


Pawnee Rock

 Ft. from N. Line

330' Ft. from S. Line

330' Ft. from E. Line

 Ft. from W. Line

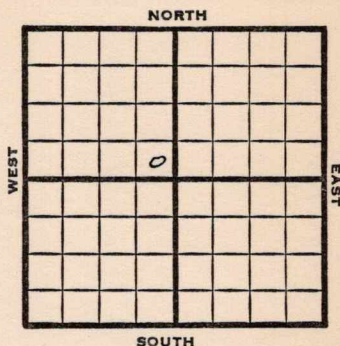

SE NW

1949

Elev 2029'

REPORT

8/17

RUR

8/24

8" @ 1038'

Drlg. 2645'

8/31

Lansing 3447'

Arbuckle 3744'

TD 3780'

5" @ 3768'

9/7

"

9/14

Swb 22 bbls oil 1 hr

9/21

TD 3777'

Arb. 3744'

5" @ 3768'

Pump 250 Oil Pot

39° Gr.

Comp

COMPLETED

Kansas

Map No. _____ Sec. 23 Twp. 20 R. 16W

Well No. 1 Dirks "B"

Vickers Company

Contractor

SE NW


FIRST REPORT
SECTION PLAT

_____ Ft. from N. Line

330 Ft. from S. Line

330 Ft. from E. Line

_____ Ft. from W. Line

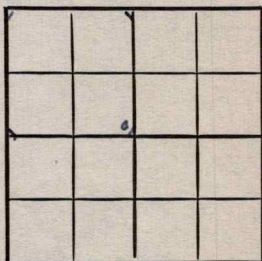

Pawnee County

RECORD

Location _____

Cased _____ in., _____ ft.

Rig up _____

Sand _____

Drilling and Remarks:

Gas _____

Oil _____

Total Depth _____

R U R

PRODUCTION

1st 24 hrs. Nat. _____

1st 24 hrs. after shot _____

Gas _____ Cu. Ft.

Dry Hole _____

Abandoned _____

Date

AUG 17 1949 19

S. J. LEWIS

Scout

Kansas

Pawnee Rock Pool

Map No. K81 Sec. 23 Twp. 20 R. 16WWell No. 1 Dirks "B"

Vickers

Company

COMPLETE

Contractor

SE NW

E. 1. 2028

SECTION PLAT

Ft. from N. Line

330

Ft. from S. Line

330

Ft. from E. Line

Ft. from W. Line

Pawnee County

Location

Rig up

Drilling and Remarks:

Re 43744

5" C3768

Pump 250 oil 20x

87 = 88

RECORD

Cased _____ in., _____ ft.

Sand _____

Gas _____

Oil _____

Total Depth 8277

PRODUCTION

1st 24 hrs. Nat. _____

1st 24 hrs. after shot _____

Gas _____ Cu. Ft.

Dry Hole _____

Abandoned _____

Date

SEP 21 1949

19

S. J. LEWIS

Scout