


KANSAS

Pawnee

Section 23 Township 20S Range 16W

Well No. #2 Dirks "B"

Company Vickers

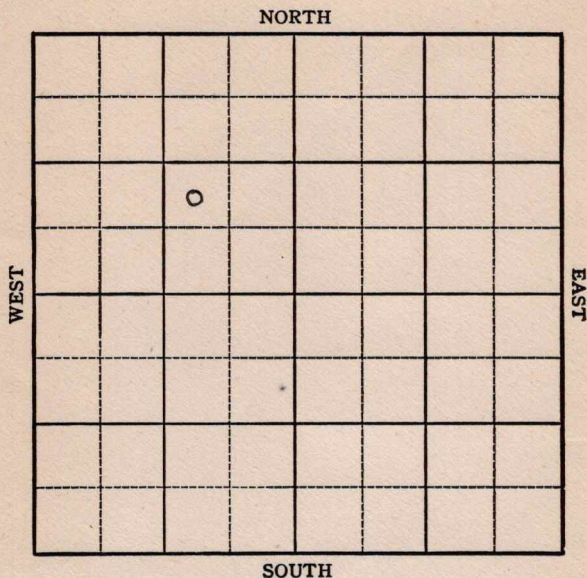

KANSAS

Pawnee



Sec. 23 Twp. 20 R. 16W

Well No. #2 Dirks "B" Farm

Vickers

Company


Pawnee Rock (Jayhawk Drlg., **NORTH.**)

 Ft. from N. Line

990' Ft. from S. Line

990' Ft. from E. Line

 Ft. from W. Line

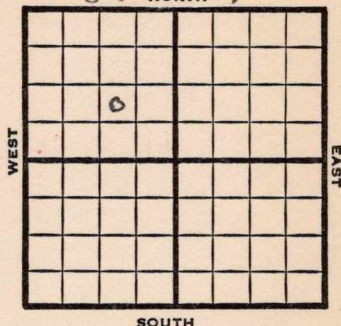

NW SE NW

SOUTH

1949

Elev 2047' REPORT

9/14

Anhy 1055'

9/21

Drlg. 3000'

9/28

Lansing 3469'

Arb. 3765'

TD 3797'

5"@ 3785'

10/5

Flow 15 Oil PH

10/12

TD 3797'

Arb. 3765'

5"@ 3785'

Flow 428 Oil Pot

39° Gr.

Comp

COMPLETED

Map No. _____ Sec. 23 Twp. 20 R. 16WWell No. 2 Dirks "B"

Vickers _____ Company

Jayhawk Drlg. _____ Contractor

NW SE NW

SECTION PLAT

	o		

_____ Ft. from N. Line

990 Ft. from S. Line990 Ft. from E. Line

_____ Ft. from W. Line

Pawnee County

Location _____

Rig up _____

Drilling and Remarks:

Anhy 1055

RECORD

Cased _____ in., _____ ft.

Sand _____

Gas _____

Oil _____

Total Depth _____

PRODUCTION

1st 24 hrs. Nat. _____

1st 24 hrs. after shot _____

Gas _____ Cu. Ft.

Dry Hole _____

Abandoned _____

Date

SEP 14 1949

19

S. J. LEWIS

Scout

Kansas

Map No. _____ Sec. 23 Twp. 20 R. 16WWell No. 2 Dirks "B"

Vickers

Company

COMPLETE

Contractor

NW SE NW

E 1,2042
SECTION PLAT

	0		

_____ Ft. from N. Line

990 Ft. from S. Line990 Ft. from E. Line

_____ Ft. from W. Line

Pawnee County

Location _____

Rig up _____

Drilling and Remarks:


RECORD

Cased _____ in., _____ ft.

Sand _____

Gas _____

Oil _____

Total Depth 3297

PRODUCTION

1st 24 hrs. Nat. _____

1st 24 hrs. after shot _____

Gas _____ Cu. Ft.

Dry Hole _____

Abandoned _____

Date

OCT 12 1949

19

S. J. LEWIS

Scout