


Section 21 Township 25 Range 2 E

Well No. #1 Melick

Company Eckland Drlg.

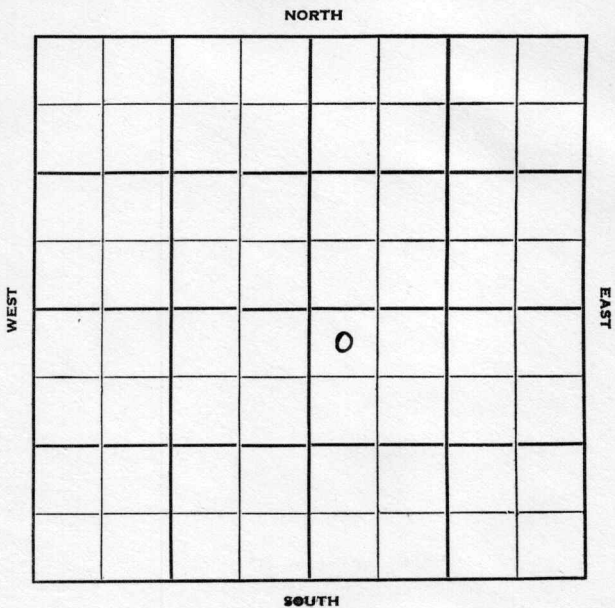

Sedgwick **KANSAS** ✓

Sec. 21 Twp. 25 R. 2E

Well No. #1 Melick Farm

Eckland Drlg. Company

Wildcat Contractor


330' Ft. from N. Line

_____ Ft. from S. Line

_____ Ft. from E. Line

330' Ft. from W. Line

NW NW SE

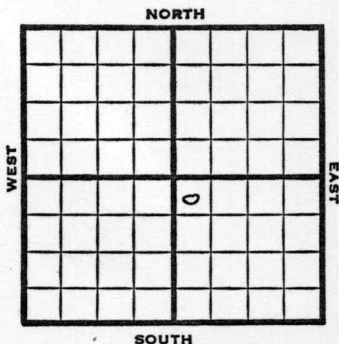

1951

REPORT

1/31
2/7

Drlg.
Adb. location
ABANDONED

County **Sedgwick** State **Kansas**

Sec. **21** (Blk. Twp.) **25** (Sur. Rge.) **2E** Map No.

Operator **Eckland Drlg.**

Well No. **1** Farm **Melick**

Elev. Location **NW NW SE**

330 Ft. From **N** Line **SE**

330 Ft. From **W** Line Quarter

1st. Report **JAN 31 1951**

Completion

Remarks

Spudding Date

Drlg. Data **Wildcat**

drlg.

County Sedgwick State Kansas

Sec. 21 (Blk. Twp.) 25 (Sur. Rge.) 2E Map No.

Operator Eckland Drlg.

Well No. 1 Farm Melick

Elev. _____ Location NW NW SE



330 Ft. From N Line SE

330 Ft. From W Line Quarter

1st. Report

Completion FEB 7 1951

Remarks Wildcat

Spudding Date

Drlg. Data

Abd. location

J. E. TYRA