


Section 23 Township 20 Range 16-WWell No. #2 Unruh "A"Company Vickers Pet.

NORTH

WEST

EAST

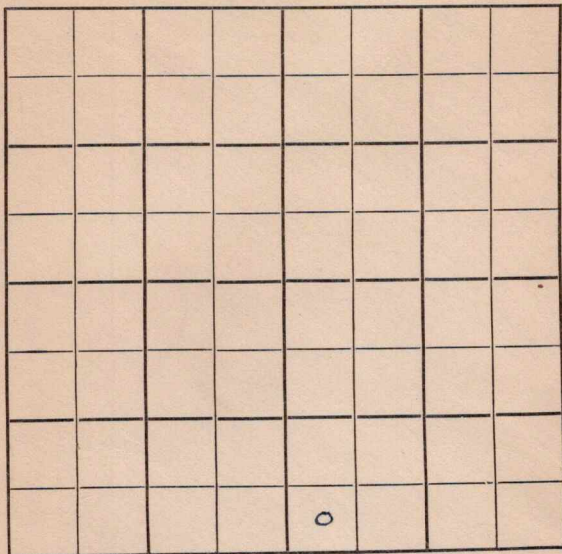

SOUTH

KANSAS

Pawnee

Sec. 23 Twp. 20 R. 16-W

Well No. #2 Unruh "A" Farm

Vickers Pet. Company

Pawnee Contractor


 Ft. from N. Line

330 Ft. from S. Line

 Ft. from E. Line

330 Ft. from W. Line

SW SW SE

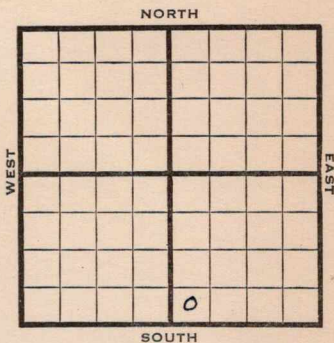

1950

Elev 2027

REPORT

7/19

Spud 7-17-50

8/30

Oil well TD 3775

Anhy 1031

8 5/8" @ 1036

Br line 3449 Arb 3743

DST 3745-60 opn 14 min rec 60' ocm
30' oil

DST 3764-75 TD opn 14 min rec 1200'
oil

5" @ 3764

CO to 3775

Comp 341 bopd

TD 3775

Completed

COMPLETED

Kansas

Map No. _____ Sec. 23 Twp. 20 R. 16WWell No. 2 Unruh "A"Vickers Pet. _____ Company_____
Contractor

SW SW SE

SECTION PLAT

_____ Ft. from N. Line

330 Ft. from S. Line

_____ Ft. from E. Line

330 Ft. from W. LinePawnee County

Location _____

Rig up _____

Drilling and Remarks:

Spud 7-17-50

RECORD

Cased _____ in., _____ ft.

Sand _____

Gas _____

Oil _____

Total Depth _____

PRODUCTION

1st 24 hrs. Nat. _____

1st 24 hrs. after shot _____

Gas _____ Cu. Ft.

Dry Hole _____

Abandoned _____

Date

JUL 19 195019J. E. TYLER Scout

J. E. TYRA