

Map No. 236 Sec. 25 Twp. 8
 Well No. 10 Farm 8
Oil Company

NORTH



SOUTH

Location -----

Rig Up -----

Drilling Remarks:

Drilling Remarks:

RECORD


Cased ----- in. ----- ft.
 Sand -----
 Gas -----
 Oil -----
 Total Depth -----

PRODUCTION

1st 24 hrs. Nat. -----
 1st 24 hrs. after shot -----
 Gas ----- cu. ft.
 Dry Hole -----
 Abandoned -----

Map No. 415 Sec. 36 Twp. 25 R. 8Well No. 5 Bryden
Great Southern Company

Contractor _____

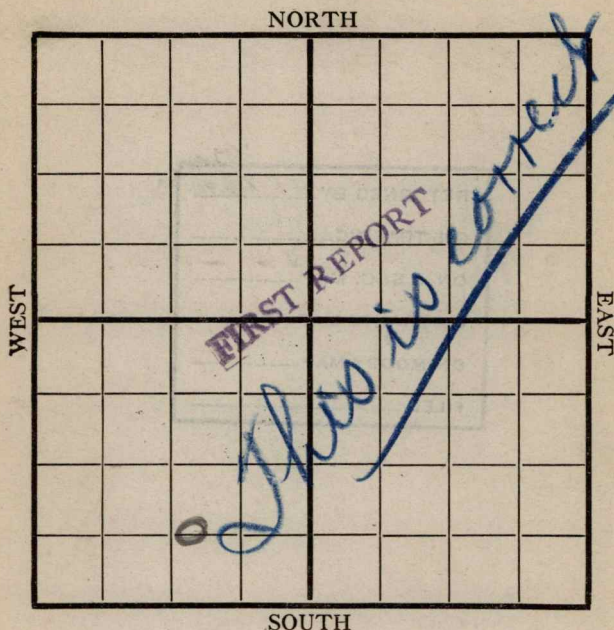

Location _____

Rig up ☒ _____

Drilling and Remarks:

Mid 1/2 own
 1/2 of S 1/4
 Didal own
 E 1/2 of S 1/4

RECORD

Cased _____ in., _____ ft.

Sand _____

Gas _____

Oil _____

Total Depth _____

PRODUCTION

1st 24 hrs. Nat. _____

1st 24 hrs. after shot _____

Gas _____ Cu. Ft.

Dry Hole _____

Abandoned _____


Date

4/14/18 1918 Pyle Scout

Map No. K15 36 Sec. 25 Twp. 8 R. 8Well No. Bryden FarmMid-Kans Company

NORTH

WEST

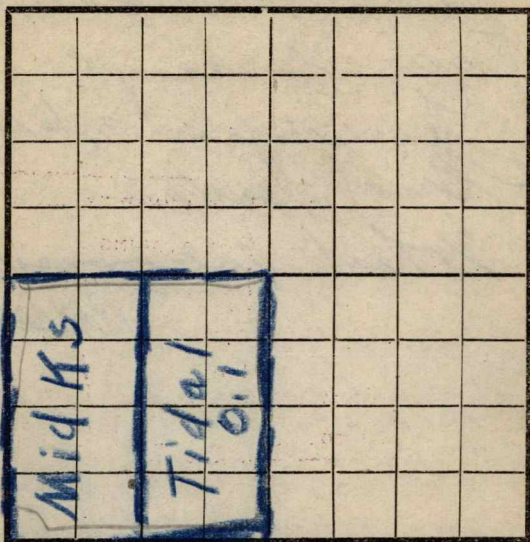

EAST

SOUTH

Location -----

Rig Up -----

Drilling and remarks

RECORD

Cased ----- in. ----- Ft.

Sand -----

Gas -----

Oil -----

Total Depth -----

PRODUCTION

1st 24 hrs. Nat. -----

1st 24 hrs. after shot -----

Gas ----- Cu. Ft.


Dry Hole -----

Abandoned -----

Date

-----, 191----- Scout

Map No. _____ Sec. _____ Twp. _____ R. _____
Well No. _____
County _____

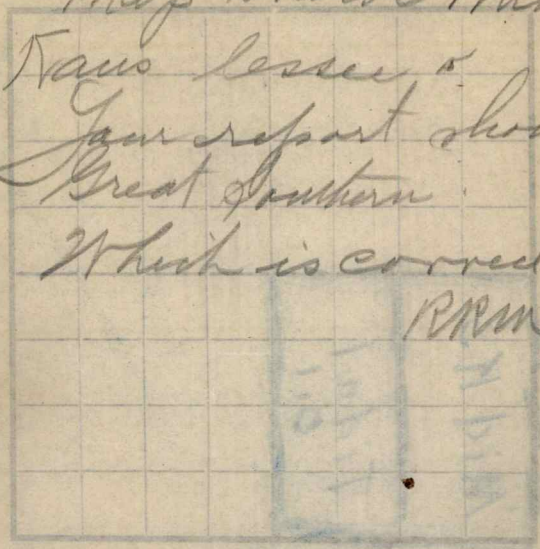

RECORD

Cased in _____ ft.
Sand _____
Gas _____
Oil _____
Total Depth _____

PRODUCTION

1st 24 hrs. Nat. _____
1st 24 hrs. after shot _____
Gas _____
Dry Hole _____
Abandoned _____

Location _____

Rise Up _____

Drilling and remarks _____

Date _____

Map No. _____ Sec. 36 Twp. 25 R. 8
Well No. 5 Bryden
Great Southern Company
Contractor _____

NORTH

WEST

EAST

SOUTH

Location _____

Rig up. ✓

Drilling and Remarks:

RECORD

Cased _____ in., _____ ft.

Sand

Gas -----

Oil _____

Total Depth.....

PRODUCTION

1st 24 hrs. Nat.

1st 24 hrs. after shot-----

Gas.....Cu. Ft.

Dry Hole

Abandoned.....

Date _____

4/21 1918 Pyle Scout


Map No. K15 Sec. 36 Twp. 25 R. 8Well No. 5 BrydenTidal Oil Company

Contractor

NORTH

WEST

EAST

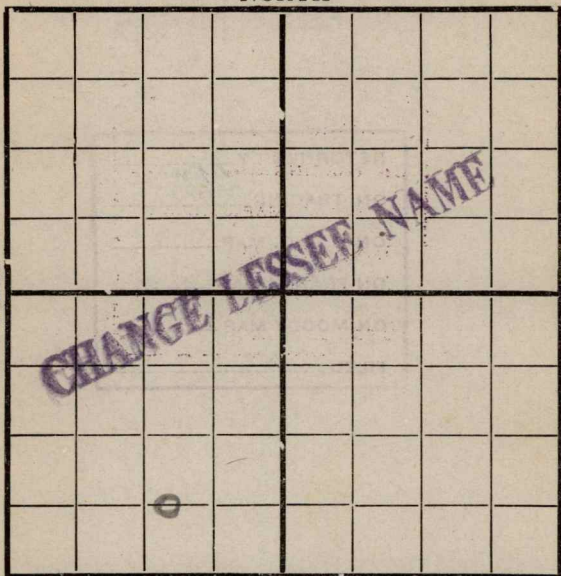

SOUTH

Location _____

Rig up _____

Drilling and Remarks:

Spudding

RECORD

Cased _____ in., _____ ft.

Sand _____

Gas _____

Oil _____

Total Depth _____

PRODUCTION

1st 24 hrs. Nat. _____

1st 24 hrs. after shot _____

Gas _____ Cu. Ft.

Dry Hole _____

Abandoned _____

Date


4/28 1918 Pyle Scout

Map No. _____ Sec. 36 Twp. 25 R. 8Well No. 5 BrydenTidal Oil _____ Company_____
Contractor

NORTH

WEST

EAST

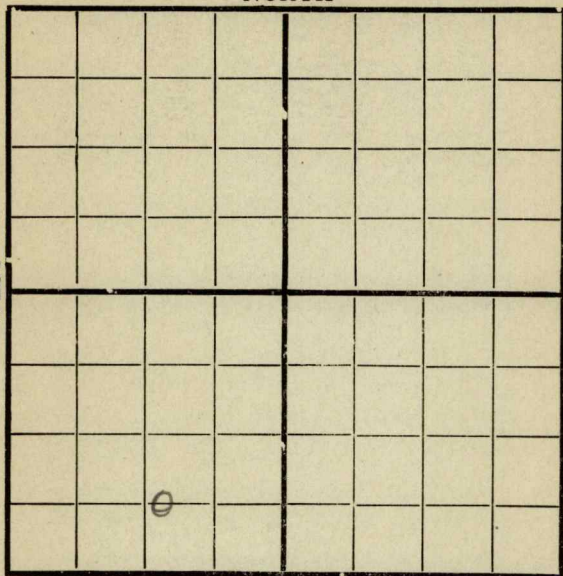

SOUTH

Location _____

Rig up _____

Drilling and Remarks:

RECORD

Cased _____ in., _____ ft.

Sand _____

Gas _____

Oil _____

Total Depth _____

PRODUCTION

1st 24 hrs. Nat. _____

1st 24 hrs. after shot _____

Gas _____ Cu. Ft.

Dry Hole _____

Abandoned _____


Date

191

Scout

7/13
8 Cycle

Map No. _____ Sec. 36 Twp. 25 R. 8
 Well No. 5 Bryden Farm _____
Tidal Oil Company _____
 Date Started _____ Ft. from N. _____ S. _____ E. _____ W. _____ line
 NORTH

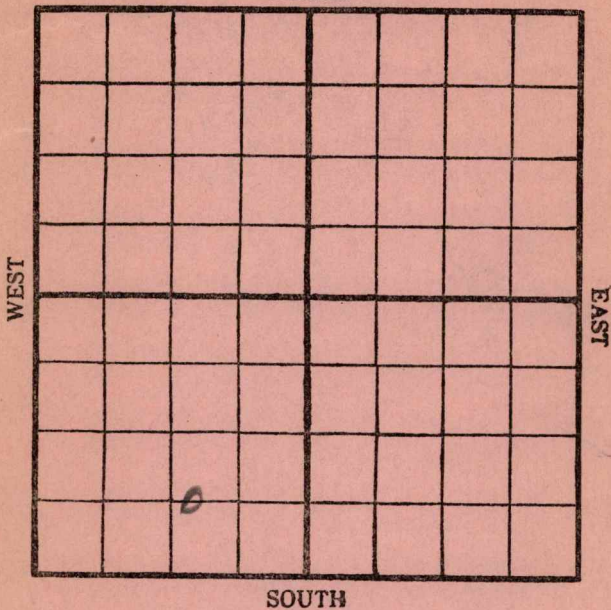

Cased _____ In. _____ Ft. _____
 Sand _____
 Pay { Gas _____
 { Oil _____
 Total Depth _____

Production Remarks

Condition of Well on this date _____

D. D. @ 200

Boiler trouble

7/6 Pyh _____ Scout


Map No. _____ Sec. 36 Twp. 25 R. 8Well No. 5 BrydenTidal Oil Company

Contractor _____

NORTH

WEST

EAST

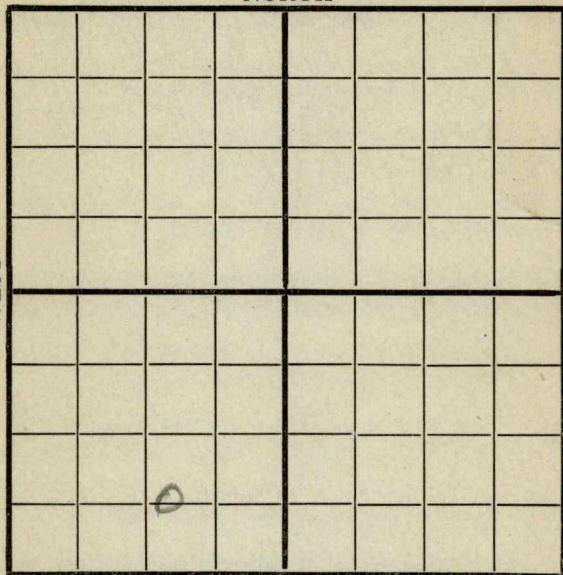

SOUTH

Location _____

Rig up _____

Drilling and Remarks:

875'

RECORD

Cased _____ in., _____ ft.

Sand _____

Gas _____

Oil _____

Total Depth _____

PRODUCTION

1st 24 hrs. Nat. _____

1st 24 hrs. after shot _____

Gas _____ Cu. Ft.

Dry Hole _____


Abandoned _____

Date

7/151918Bryden

Scout


Map No. _____ Sec. 36 Twp. 25 R. 8
Well No. 5 Bryden
Tidal Oil Company
Contractor _____

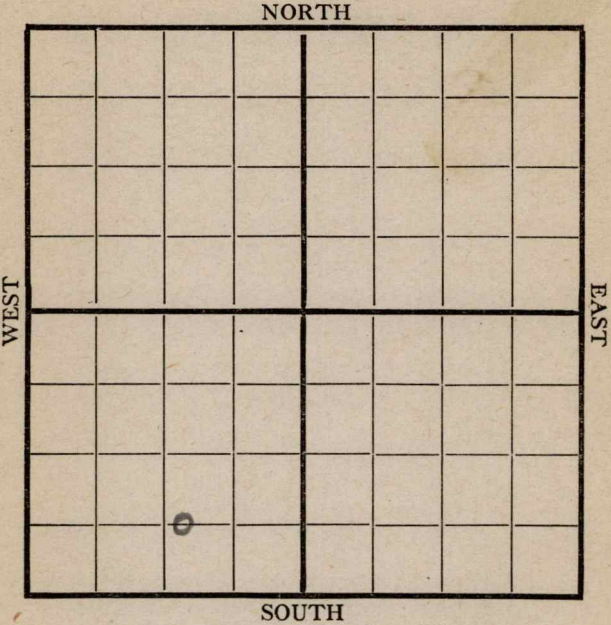

Location _____ Rig up _____ Drilling and Remarks: <u>10" @ 1130'</u>	RECORD Cased _____ in., _____ ft. Sand _____ Gas _____ Oil _____ Total Depth _____
	PRODUCTION 1st 24 hrs. Nat. _____ 1st 24 hrs. after shot _____ Gas _____ Cu. Ft. Dry Hole _____ Abandoned _____

Date 7/27 1918 Cyle Scout

Map No. _____ Sec. 36 Twp. 25 R. 8
Well No. 5 Bryden
Tidal Oil Company _____
Contractor _____

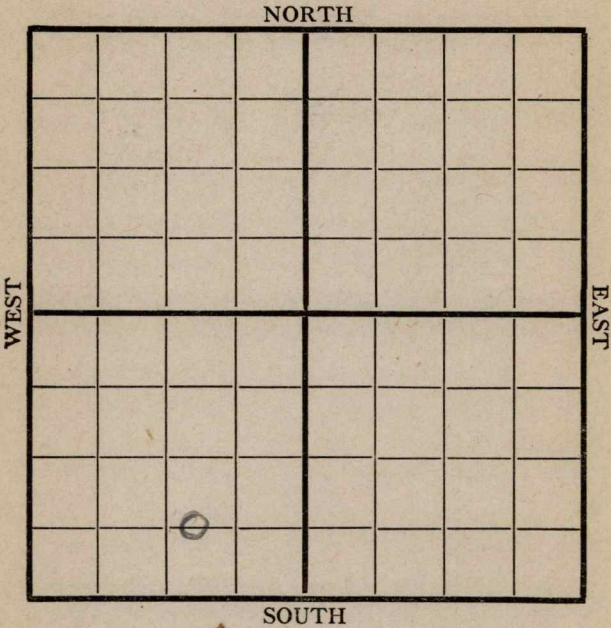

Location 660' R
1070' E
Rig up _____
Drilling and Remarks:

1400'

RECORD

Cased _____ in., _____ ft.
Sand _____
Gas _____
Oil _____
Total Depth _____

PRODUCTION

1st 24 hrs. Nat. _____
1st 24 hrs. after shot _____
Gas _____ Cu. Ft.
Dry Hole _____
Abandoned _____

Date 8/3 1918 Cyle Scout _____

Map No. _____ Sec. 36 Twp. 25 R. 8

Well No. 5 Boydin


Tidal Oil Company

Contractor _____

NORTH

WEST

EAST

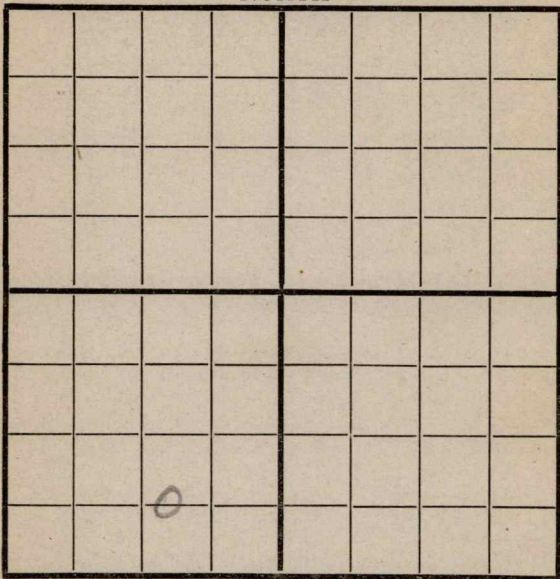

SOUTH

6602

Location 1070 E

Rig up _____

Drilling and Remarks:

1790

RECORD

Cased _____ in., _____ ft.

Sand _____

Gas _____

Oil _____

Total Depth _____

PRODUCTION

1st 24 hrs. Nat. _____

1st 24 hrs. after shot _____

Gas _____ Cu. Ft.

Dry Hole _____

Abandoned _____

Date 8/5

1918

Tyler Scout


Map No. _____ Sec. 36 Twp. 25 R. 8
 Well No. 5 Bryden
Tidal Oil Company _____
 Contractor _____

NORTH									
WEST									EAST
SOUTH									

Location <u>1070 E</u> Rig up _____ Drilling and Remarks: <u>Running</u> <u>6" casing</u>	RECORD Cased _____ in., _____ ft. Sand <u>2343-2389</u> Gas _____ Oil _____ Total Depth _____ PRODUCTION 1st 24 hrs. Nat. _____ 1st 24 hrs. after shot _____ Gas _____ Cu. Ft. Dry Hole _____ Abandoned _____
---	--

Date 8/17 1918 Cyle Scout

Map No. K15 Sec. 36 Twp. 25 R. 8
 Well No. 5 Bryden
Tidal Oil Company
 Contractor

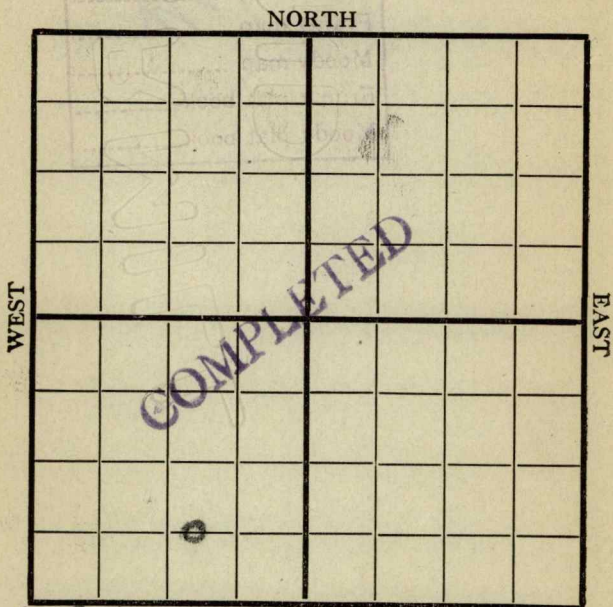

SOUTH 660A-1070 E

Location _____
 Rig up _____
 Drilling and Remarks:

Shot 120 gals
Est - 60 bbls

RECORD

Cased _____ in., _____ ft.
 Sand 2345-2391
 Gas _____
 Oil _____
 Total Depth _____

PRODUCTION

1st 24 hrs. Nat. _____
 1st 24 hrs. after shot _____
 Gas _____ Cu. Ft.
 Dry Hole _____
 Abandoned _____

Date

8/24