


Map No. \_\_\_\_\_ Sec. 36 Twp. 25 R. 8  
Well No. 6 Brydens Farm \_\_\_\_\_  
Mid-Kansas Company \_\_\_\_\_

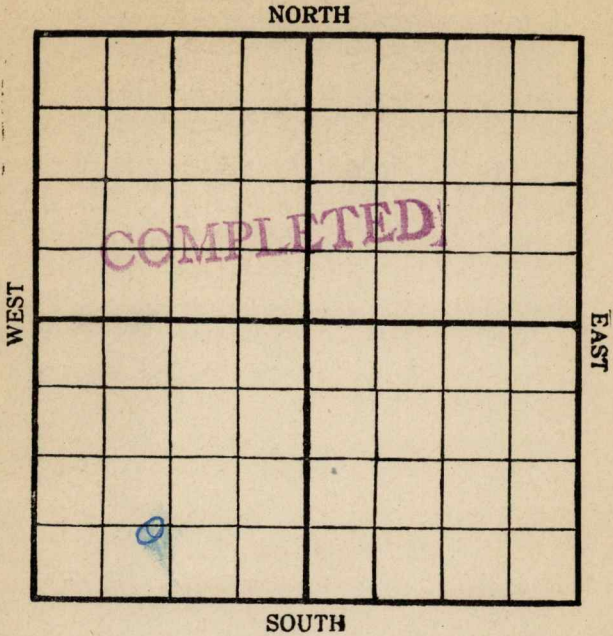

Location \_\_\_\_\_

Rig Up \_\_\_\_\_

Drilling Remarks:

Drilling Remarks:

100 ft. to 100 ft. —  
5/21/18

7343-2391

RECORD

PRODUCTION

Cased \_\_\_\_\_ in. \_\_\_\_\_ ft.  
Sand \_\_\_\_\_  
Gas \_\_\_\_\_  
Oil \_\_\_\_\_  
Total Depth \_\_\_\_\_

1st 24 hrs. Nat. \_\_\_\_\_  
1st 24 hrs. after shot \_\_\_\_\_  
Gas \_\_\_\_\_ cu. ft.  
Dry Hole \_\_\_\_\_  
Abandoned \_\_\_\_\_

Map No. *K15* Sec. *36* Twp. *25* R. *5*Well No. *6 Bryden* Farm*Mid Kansas* Company

NORTH

WEST

EAST

SOUTH

## RECORD

Location -----

Cased ----- in. ----- Ft.

Rig Up -----

Sand -----

Drilling and remarks

Gas -----

Oil -----

Total Depth -----

## PRODUCTION

1st 24 hrs. Nat. -----

1st 24 hrs. after shot -----

Gas ----- Cu. Ft.

Dry Hole -----

Abandoned -----


Date

*3/8*, 191*8**29* Scout

Map No. \_\_\_\_\_ Sec. 36 Twp. 25 R. 8Well No. 6 Bryden Farm \_\_\_\_\_  
Mid - Kansas Company

NORTH

WEST

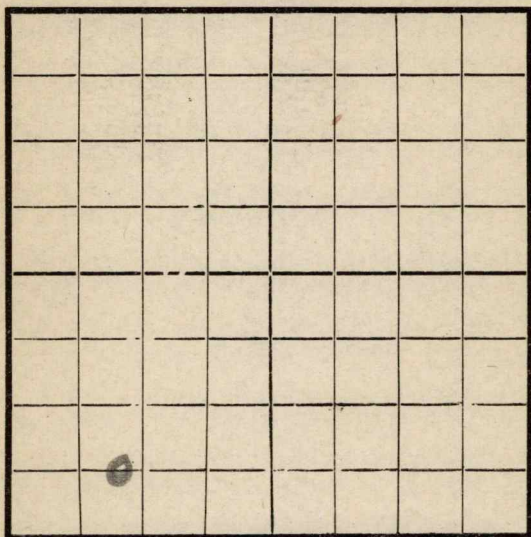

SOUTH

Location \_\_\_\_\_

Rig Up \_\_\_\_\_

Drilling and remarks

## RECORD

Cased \_\_\_\_\_ in. \_\_\_\_\_ Ft.

Sand \_\_\_\_\_

Gas \_\_\_\_\_

Oil \_\_\_\_\_

Total Depth \_\_\_\_\_

## PRODUCTION

1st 24 hrs. Nat. \_\_\_\_\_

1st 24 hrs. after shot \_\_\_\_\_

Gas \_\_\_\_\_ Cu. Ft.

Dry Hole \_\_\_\_\_

Abandoned \_\_\_\_\_


Date

4/11, 1918Scout Cy C

Map No. \_\_\_\_\_ Sec. 36 Twp. 25 R. 8  
 Well No. 6 Boyd Farm \_\_\_\_\_  
Mid-Kansas Company \_\_\_\_\_

NORTH

WEST

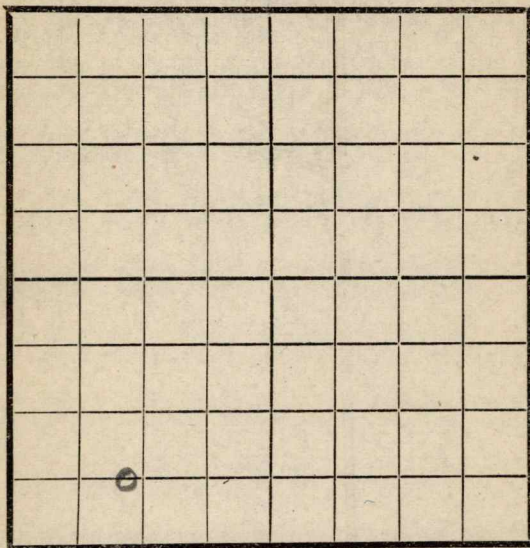

EAST

SOUTH

| RECORD                                  |                              |
|-----------------------------------------|------------------------------|
| Location _____                          | Cased _____ in. _____ Ft.    |
| Rig Up _____                            | Sand _____                   |
| Drilling and remarks<br><br><u>350'</u> | Gas _____                    |
|                                         | Oil _____                    |
|                                         | Total Depth _____            |
|                                         | PRODUCTION                   |
|                                         | 1st 24 hrs. Nat. _____       |
|                                         | 1st 24 hrs. after shot _____ |
|                                         | Gas _____ Cu. Ft.            |
|                                         | Dry Hole _____               |
|                                         | Abandoned _____              |


Date 4/20, 1918 Oyler Scout \_\_\_\_\_

Map No. \_\_\_\_\_ Sec. 36 Twp. 25 R. 8  
 Well No. 6 Bryden Farm \_\_\_\_\_  
Mid-Kansas Company \_\_\_\_\_

NORTH

WEST

EAST

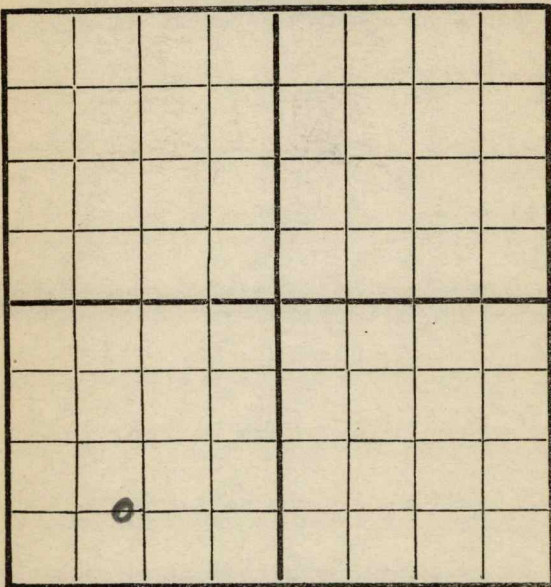

SOUTH

Location \_\_\_\_\_  
 Rig Up \_\_\_\_\_  
 Drilling and remarks \_\_\_\_\_

RECORD

Cased \_\_\_\_\_ in. \_\_\_\_\_ Ft.  
 Sand \_\_\_\_\_  
 Gas \_\_\_\_\_  
 Oil \_\_\_\_\_  
 Total Depth \_\_\_\_\_


PRODUCTION

1st 24 hrs. Nat. \_\_\_\_\_  
 1st 24 hrs. after shot \_\_\_\_\_  
 Gas \_\_\_\_\_ Cu. Ft.  
 Dry Hole \_\_\_\_\_  
 Abandoned \_\_\_\_\_

Date 4/22, 1918 Bryden Scout \_\_\_\_\_

Map No. \_\_\_\_\_ Sec. 36 Twp. 25 R. 5  
 Well No. 6 Bryden Farm \_\_\_\_\_  
Mid-Kano Company \_\_\_\_\_

NORTH

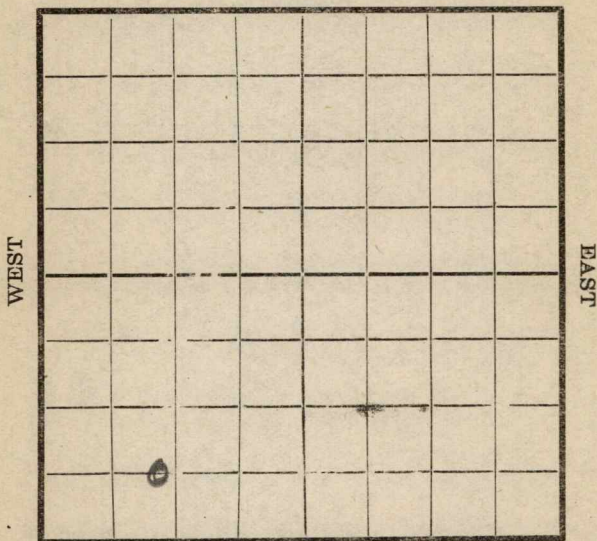

SOUTH

Location \_\_\_\_\_  
 Rig Up \_\_\_\_\_  
 Drilling and remarks \_\_\_\_\_

1200'

RECORD

Cased \_\_\_\_\_ in. \_\_\_\_\_ Ft.  
 Sand \_\_\_\_\_  
 Gas \_\_\_\_\_  
 Oil \_\_\_\_\_  
 Total Depth \_\_\_\_\_

PRODUCTION


1st 24 hrs. Nat. \_\_\_\_\_  
 1st 24 hrs. after shot \_\_\_\_\_  
 Gas \_\_\_\_\_ Cu. Ft.  
 Dry Hole \_\_\_\_\_  
 Abandoned \_\_\_\_\_

Date 5/4, 1918 Cyle Scout

Map No. \_\_\_\_\_ Sec. 36 Twp 25-8 R. \_\_\_\_\_  
 Well No. 6 Bryden Farm \_\_\_\_\_  
Mid-Kansas Oil Company

NORTH

WEST

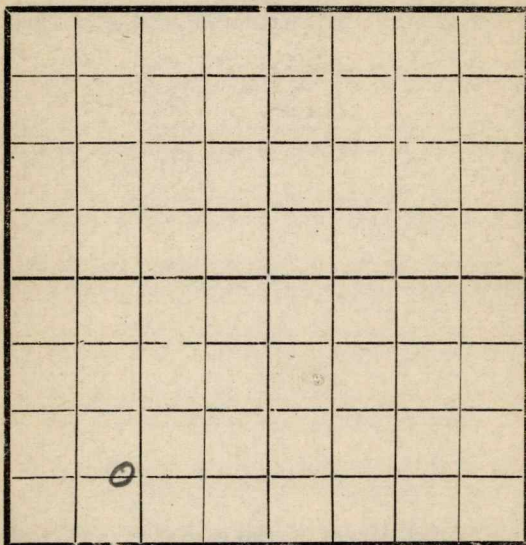

EAST

SOUTH

Location \_\_\_\_\_  
 Rig Up \_\_\_\_\_  
 Drilling and remarks \_\_\_\_\_

**RECORD**  
 Cased \_\_\_\_\_ in. \_\_\_\_\_ Ft.  
 Sand \_\_\_\_\_  
 Gas \_\_\_\_\_  
 Oil \_\_\_\_\_  
 Total Depth \_\_\_\_\_

**PRODUCTION**  
 1st 24 hrs. Nat. \_\_\_\_\_  
 1st 24 hrs. after shot \_\_\_\_\_  
 Gas \_\_\_\_\_ Cu. Ft.  
 Dry Hole \_\_\_\_\_  
 Abandoned \_\_\_\_\_

Date

5/11, 1918 Oyle Scout

Map No. \_\_\_\_\_ Sec. 36 Twp. 25 R. 8Well No. 6 BrydenMid-Kansas Company

Contractor \_\_\_\_\_

NORTH

WEST

EAST

SOUTH

Location \_\_\_\_\_

Rig up \_\_\_\_\_

Drilling and Remarks:

## RECORD

Cased \_\_\_\_\_ in., \_\_\_\_\_ ft.

Sand \_\_\_\_\_

Gas \_\_\_\_\_

Oil \_\_\_\_\_

Total Depth \_\_\_\_\_

## PRODUCTION

1st 24 hrs. Nat. \_\_\_\_\_

1st 24 hrs. after shot \_\_\_\_\_

Gas \_\_\_\_\_ Cu. Ft.

Dry Hole \_\_\_\_\_

Abandoned \_\_\_\_\_

Date

5/8 1918 Jyle Scout

Map No. \_\_\_\_\_ Sec. 36 Twp. 25 R. 8Well No. 6 BrydenMid Kansas Company

Contractor \_\_\_\_\_

NORTH

WEST

EAST

SOUTH

Location \_\_\_\_\_

Rig up \_\_\_\_\_

Drilling and Remarks:

## RECORD

Cased \_\_\_\_\_ in., \_\_\_\_\_ ft.

Sand \_\_\_\_\_

Gas \_\_\_\_\_

Oil \_\_\_\_\_

Total Depth \_\_\_\_\_

## PRODUCTION

1st 24 hrs. Nat. \_\_\_\_\_

1st 24 hrs. after shot \_\_\_\_\_

Gas \_\_\_\_\_ Cu. Ft.

Dry Hole \_\_\_\_\_

Abandoned \_\_\_\_\_

Date

5/1/18 191Lyle Scout


Map No. K15 Sec. 36 Twp. 25 R. 8Well No. 6 BrydenMid-Kansas Oil Company

Contractor \_\_\_\_\_

NORTH

WEST

EAST

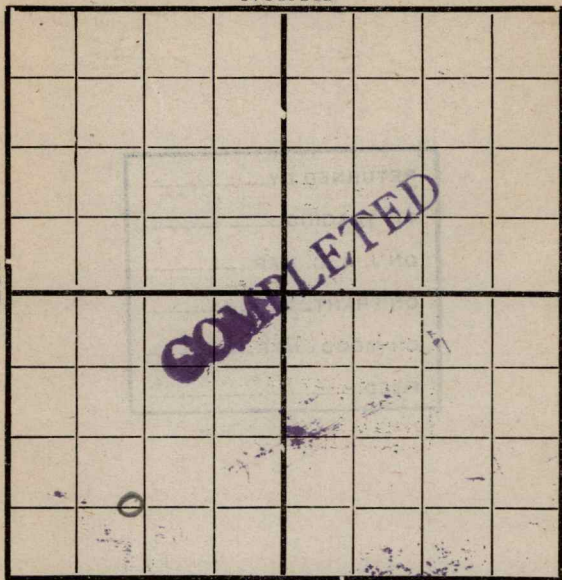

SOUTH

Location \_\_\_\_\_

Rig up \_\_\_\_\_

Drilling and Remarks:

Shot 40 gts  
Est 100 bbls

## RECORD

Cased \_\_\_\_\_ in., \_\_\_\_\_ ft.

Sand 2345-2391

Gas \_\_\_\_\_

Oil \_\_\_\_\_

Total Depth \_\_\_\_\_

## PRODUCTION

1st 24 hrs. Nat. \_\_\_\_\_

1st 24 hrs. after shot \_\_\_\_\_

Gas \_\_\_\_\_ Cu. Ft.

Dry Hole \_\_\_\_\_

Abandoned \_\_\_\_\_

Date

191

Scout

Map No. K15 Sec 36 Twp. 25 R. 8Well No. 6 BrydenMid-Kansas Company

Contractor

NORTH

WEST

EAST

COMPLETED

SOUTH

Location \_\_\_\_\_

Rig up \_\_\_\_\_

Drilling and Remarks:

Shot 40 gts

## RECORD

Cased \_\_\_\_\_ in. \_\_\_\_\_ ft.

Sand 2345-2391

Gas \_\_\_\_\_

Oil \_\_\_\_\_

Total Depth \_\_\_\_\_

## PRODUCTION

1st 24 hrs. Nat. \_\_\_\_\_

1st 24 hrs. after shot 200 bbl

Gas \_\_\_\_\_ Cu. Ft.

Dry Hole \_\_\_\_\_

Abandoned \_\_\_\_\_

Date

6/7 1918J. J. Pryce

Scout