


Map No. *K15* Sec. *36* Twp. *25* R. *8*

Well No. *7 Bryden*
Mid-Kansas Company

Contractor

NORTH

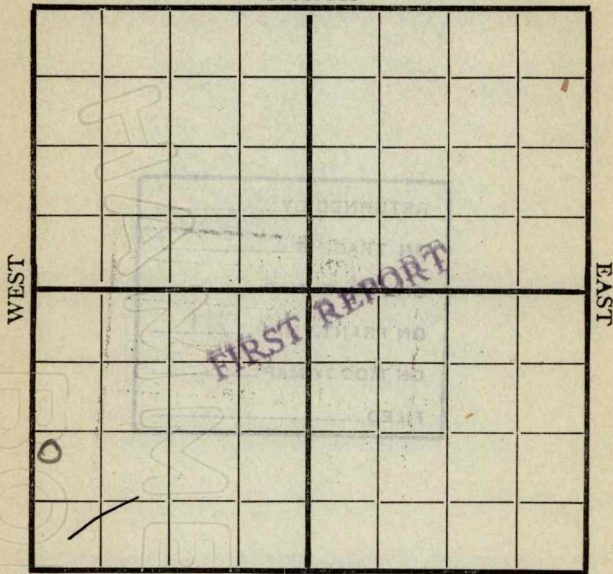

SOUTH

Location _____

Rig up

Drilling and Remarks:

RECORD

Cased _____ in., _____ ft.

Sand _____

Gas _____

Oil _____

Total Depth _____

PRODUCTION

1st 24 hrs. Nat. _____

1st 24 hrs. after shot _____

Gas _____ Cu. Ft.

Dry Hole _____

Abandoned _____

Date


5/18 191*8* *Oyle* Scout

Map No. _____ Sec. 36 Twp. 25 R. 8

Well No. 7 Bryden

Mid-Kans Company

Contractor

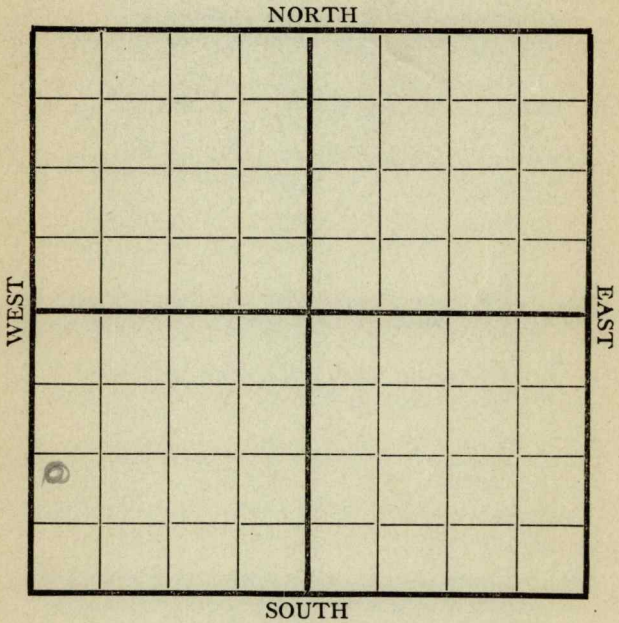

Location _____

Rig up

Drilling and Remarks:

RECORD

Cased _____ in., _____ ft.

Sand _____

Gas _____

Oil _____

Total Depth _____

PRODUCTION

1st 24 hrs. Nat. _____

1st 24 hrs. after shot _____

Gas _____ Cu. Ft.

Dry Hole _____

Abandoned _____

Date

5/4 1918 Pye Scout


Map No. _____ Sec. 36 Twp. 25 R. 8

Well No. 7 Bryden

Mid-Kedusa Oil Company

Contractor _____

NORTH

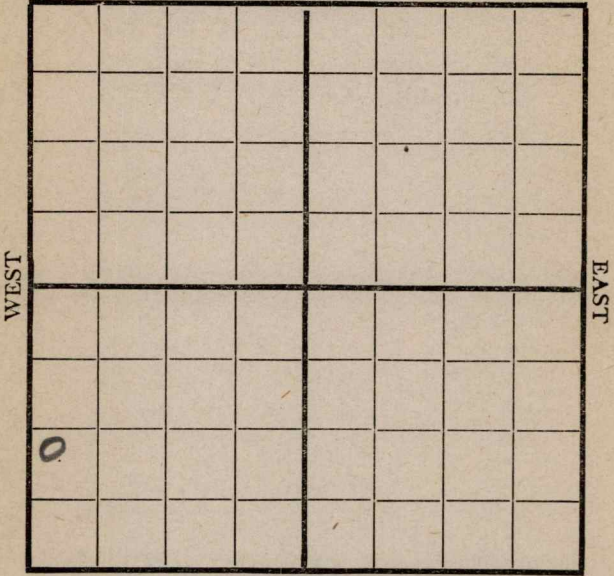

SOUTH

Location _____

Rig up _____

Drilling and Remarks:

500'

RECORD

Cased _____ in., _____ ft.

Sand _____

Gas _____

Oil _____

Total Depth _____

PRODUCTION

1st 24 hrs. Nat. _____

1st 24 hrs. after shot _____

Gas _____ Cu. Ft.


Dry Hole _____

Abandoned _____

Date

6/7 1918 Scout

Map No. _____ Sec. 36 Twp. 25 R. 8
 Well No. 7 Bryden
Mid Kansas Oil Company
 _____ Contractor

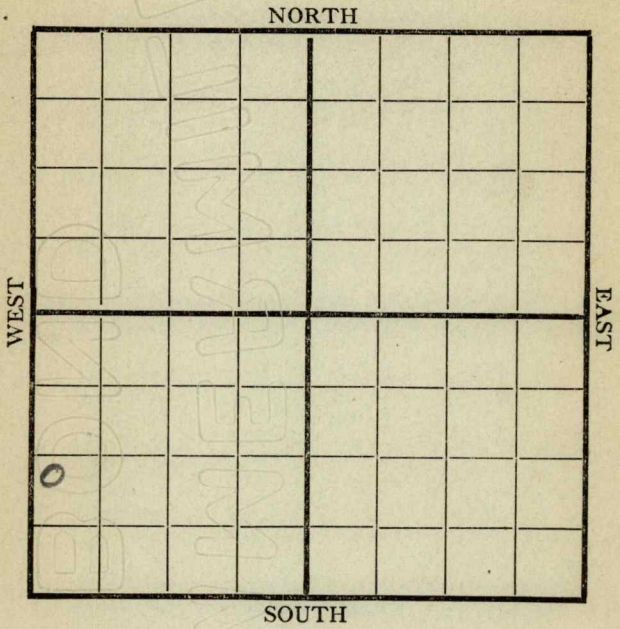


Location _____ Rig up _____ Drilling and Remarks: <div style="font-size: 2em; font-family: cursive;">1950</div>	<p style="text-align: center;">RECORD</p> Cased _____ in., _____ ft. Sand _____ Gas _____ Oil _____ Total Depth _____ <hr/> <p style="text-align: center;">PRODUCTION</p> 1st 24 hrs. Nat. _____ 1st 24 hrs. after shot _____ Gas _____ Cu. Ft. Dry Hole _____ Abandoned _____
--	---

Date 6/21 1950 Pyle Scout

Map No. K 15 Sec. 36 Twp. 25 R. 8
Well No. 7 Bryden Farm
Mid. Kansas Company
Date Started _____ Ft. from N. S. E. W. line

NORTH

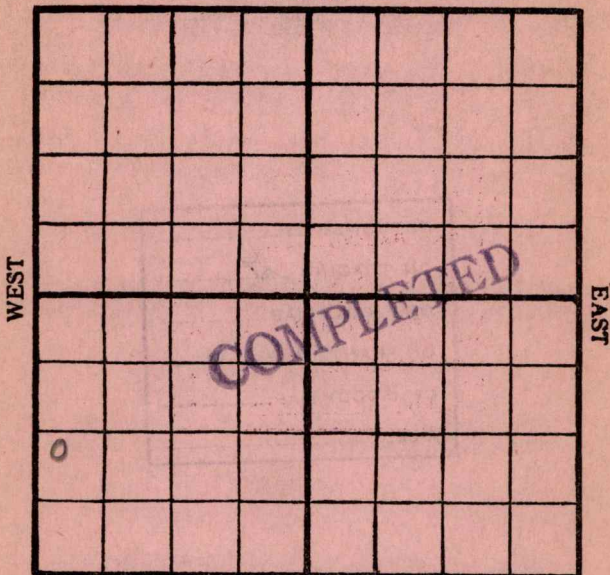

SOUTH

Cased _____ In. _____ Ft. _____

Sand 2305-2312

Pay { Gas _____
Oil _____

Total Depth _____

Production Remarks

shot 140 gals

Condition of Well on this date _____

180 bbls

7/6 Oy b Scout