
FORM 51 25M 8-50 WESTERN Pawnee KANSAS

Section 23 Township 20 Range 16W

Well No. #3 Dirks "B"

Company Vickers Pet.

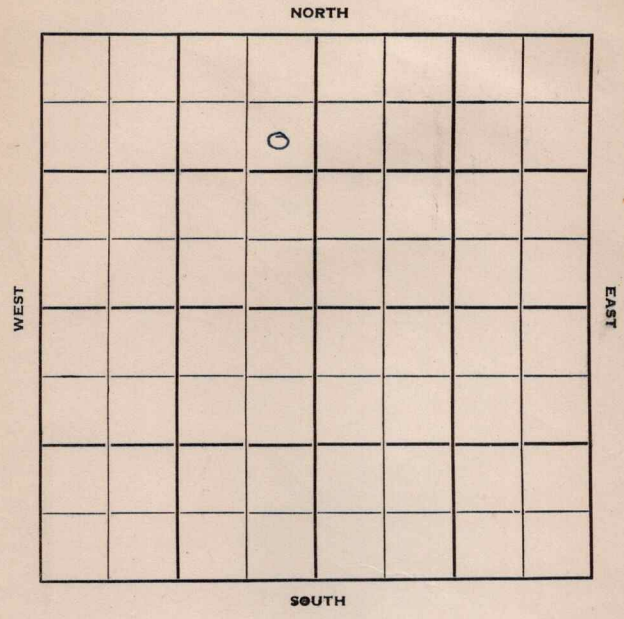

FORM 252-B
10M 11-50 PETROL

Pawnee

KANSAS

Sec. 23 Twp. 20 R. 16 W

Well No. # 3 Dirks "B" Farm

Vickers Pet. Company

Contractor

Pawnee Rock Pool


990 Ft. from N. Line

Ft. from S. Line

330 Ft. from E. Line

Ft. from W. Line

SE NE NW

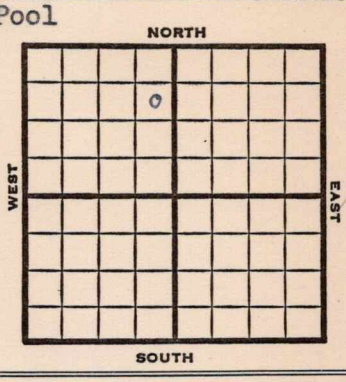

1951	Elev. 2038' REPORT
9/5	Location
10/17	Spud 9-8-51 Oil Well TD 3788' 8" @ 1047 Heeb. 3373 Br. Lime 3454 Arb. 3753 DST 3758-73 open 12 min. Rec. 160' O&GCM, 10' oil, 1,200,000 gas TD 3785' 5" @ 3373 DD 3787 S/ 3 BOPH DD 3788 S/ 5 BOPH Comp. F/ 610 BOPD COMPLETED

FORM 275 FOR SALE BY KANSAS BLUE PRINT CO.

County Pawnee State Kansas

Sec. 23 (Blk. / Twp.) 20 (Sur. / Rge.) 16W Map No.

Operator Vickers Pet.

Well No. 3 Farm Dirks "B"

Elev. Location SE NE NW



990 Ft. From N Line NW

330 Ft. From E Line Quarter

1st. Report SEP 5 1951

Completion

Remarks

Spudding Date

Drlg. Data Pawnee Rock Pool

Location

J. E. TYRA

FORM 275 FOR SALE BY KANSAS BLUE PRINT CO.


County Pawnee State Kansas

Sec. 23 (Blk. Twp.) 20 (Sur. Rge.) 16W Map No.

Operator Vickers Pet.

Well No. 3 Farm Dirks "B"

Elev. 2038 Location SE NE NW

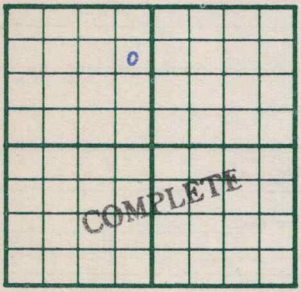

990 Ft. From N Line NW

330 Ft. From E Line Quarter

1st. Report

Completion OCT 17 1951

Remarks Pawnee Rock Pool

Spudding Date 9-8-51

Drlg. Data Oil well TD 3788

8" @ 1047 Heeb. 3373 Br. lime 3454

Arb. 3753 DST 3758-73 open 12 min.

Rec. 160' o & gcm 10' oil 1,200,000 gas

TD 3785 5" @ 3773 DD 3787 S/ 3 boph

DD 3788 S/ 5 boph Comp. F/ 610 bopd

J. E. TYRA