

Pawnee


KANSAS

Section 23 Township 20 Range 16W

Well No. #4 Dirks "A"

Company Vickers Petroleum et al

NORTH

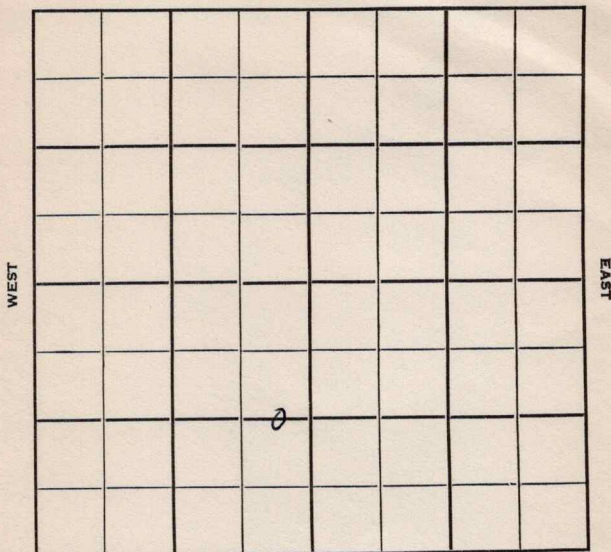

SOUTH

Pawnee

KANSAS

Sec. 23 Twp. 20 R. 16W

Well No. #4 Dirks "A" Farm

Vickers Petroleum et al Company

W. Pawnee Rock Pool Contractor

Ft. from N. Line

1320'


Ft. from S. Line

330'

Ft. from E. Line

Ft. from W. Line

C E L E $\frac{1}{2}$ SW

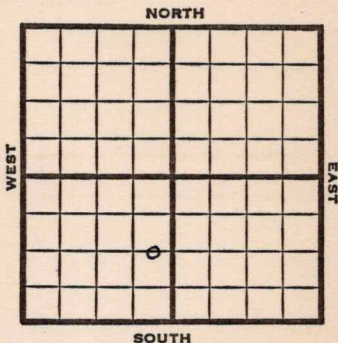

1951

REPORT

6/6 RUR

7/18

Spud 6-8-51

Oil Well TD 3775

Anhy 1028 8" @ 1030

Heeb. 3354 Br Lime 3437

Arb. 3733 TD 3770

5" @ 3762 S/13 boph DD 3772

no inc. DD 3775 14 boph

Comp. 611 bopd

COMPLETED

County Pawnee State KansasSec. 23 (Blk.) 20 (Sur.) 16W Map No.Operator Vickers Petroleum etal.Well No. 4 Farm Dirks "A"Elev. Location C E L E $\frac{1}{2}$ SW1320 Ft. From S Line SW330 Ft. From E Line Quarter1st. Report JUN 6 1951

Completion


Remarks

Spudding Date

Drlg. Data W. Pawnee Rock PoolR U R

J. E. TYRA

County Pawnee State Kansas
 Sec. 23 (Blk.) 20 (Sur.) 16W Map No.
 Operator Vickers Petroleum etal.
 Well No. 4 Farm Dirks "A"
 Elev. 2025 Location C E L E $\frac{1}{2}$ SW

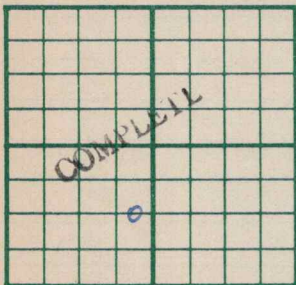

1320 Ft. From S Line SW
330 Ft. From E Line Quarter

1st. Report

Completion JUL 18 1951

Remarks W. Pawnee Rock Pool

Spudding Date 6-8-51

Drlg. Data Oil well TD 3775

Anhy 1028 8" @ 1030 Heeb. 3354

Br. lime 3437 Arb. 3733 TD 3770

5" @ 3762 S/ 13 boph DD 3772 no inc.

DD 3775 14 boph Comp. 611 bopd

J. E. TYRA