FORM 51 25M 8-50 WESTERN


Pawnee

KANSAS

Section 23 Township 20 Range 16 W

Well No. # 4 Dirks "B"

Company Vickers Petroleum

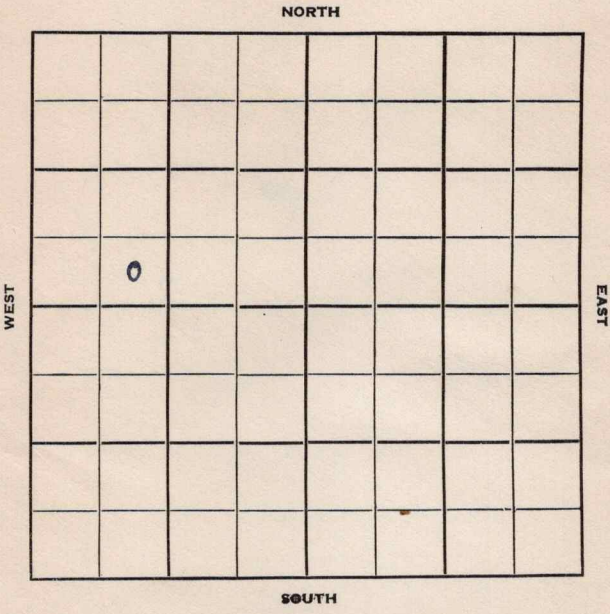

FORM 252-B
10M 10-50 PETROL

Pawnee

KANSAS

Sec. 23 Twp. 20 R. 16W

Well No. #4 Dirke "B" Farm

Vickers Pet. Company

Jayhawk Drlg. Contractor


____ Ft. from N. Line

330 Ft. from S. Line

____ Ft. from E. Line

990 Ft. from W. Line

SE SW NW

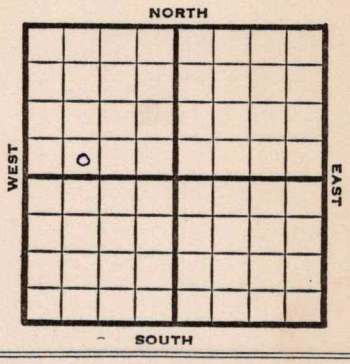

1952	Elev. 2051' REPORT
3/19	Spud 3-19-52 Drlg.
3/25	8" @ 1062' Drlg. 2600'
4/1	Heeb 3387' Br li 3469' Arb. 3768' DST 3773-85, 12 mins, 60' O & GCM, 240' oil, 60' SW, 1010# DST 3786-3800, 1/4 hr, 660' oil, 210' OCM, 30' SW, 1010# RTD 3800' 5" @ 3800
4/9	NR
4/23	24/3786-94 S/10 BOPH
4/30	Spud 3-19-52 Oil Well TD 3800' 8" @ 1062' Heeb. 3387 Br Li 3469 Arb. 3768 DST 3773-85 open 12 min. rec. 60' O&GCM 240' oil 60' sw DST 3786-3800 open 15 min. rec. 660' oil 210' mco 30' sw TD 3800' 5" @ 3800 24/ 3786-94 S/ 10 boph Comp. 100 bopd 3% wtr.

COMPLETED

FORM 275 FOR SALE BY KANSAS BLUE PRINT CO.


County Pawnee State Kansas

Sec. 23 (Blk. / Twp.) 20 (Sur. / Rge.) 16W Map No.

Operator Vickers Petroleum

Well No. 4 Farm Dirks "B"

Elev. Location SE SW NW

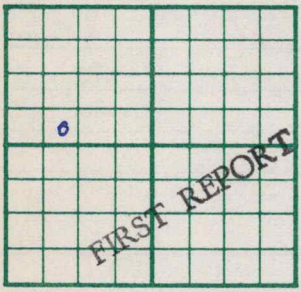

330 Ft. From S Line NW

990 Ft. From W Line Quarter

1st. Report MAR 19 1952

Completion

Remarks Jayhawk Drlg. - Contr.

Spudding Date 3-19-52

Drlg. Data

drlg.

J. G. McGEHEE

FORM 275 FOR SALE BY KANSAS BLUE PRINT CO.


County Pawnee State Kansas

Sec. 23 (Blk. Twp.) 20 (Sur. Rge.) 16W Map No.

Operator Vickers Pet.

Well No. 4 Farm Dirks "B"

Elev. 2051 Location SE SW NW

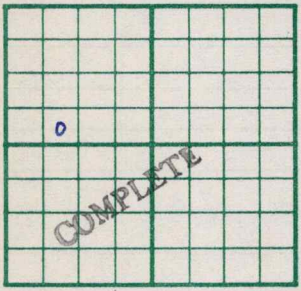

330 Ft. From S Line NW

990 Ft. From W Line Quarter

1st. Report

Completion APR 30 1952

Remarks

Jayhawk Drlg. - Contr.

Spudding Date 3-19-52

Drlg. Data Oil well TD 3800

8" @ 1062 Heeb. 3387 Br. lime 3469

Arb. 3768 DST 3773-85 open 12 min.

Rec. 60' o & gcm 240' oil 60' sw

DST 3786-3800 open 15 min. Rec. 660' oil

210' mco 30' sw TD 3800 5" @ 3800

24/ 3786-94 S/ 10 boph

Comp. 100 bopd 3% water

J. G. McGEHEE