
FORM 51 25M 3-49 PETROL Pawnee KANSAS

Section 23 Township 20 Range 16W

Well No. #5 Dirks "A"

Company Vickers et al

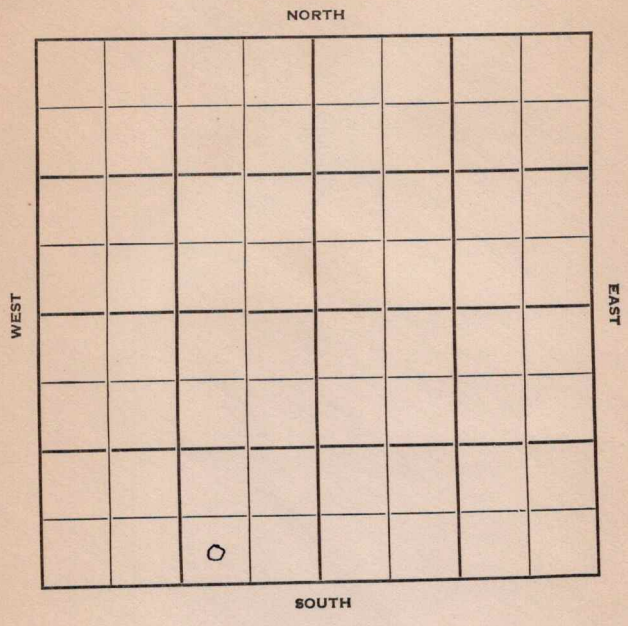

FORM 252-B
10M 11-50 PETROL

Pawnee

KANSAS

Sec. 23 Twp. 20 R. 16 W

Well No. # 5 Dirks "A" Farm

Vickers et al Company

Contractor

Pawnee Rock Pool


Ft. from N. Line

330 Ft. from S. Line

990 Ft. from E. Line

Ft. from W. Line

SW SE SW

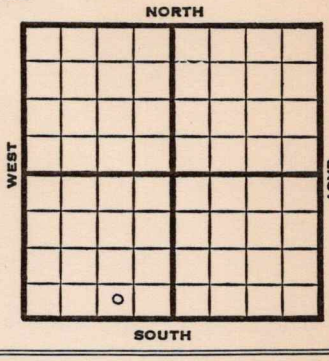

1951	Elev. 2022' REPORT
8/22 10/3	Location Spud 9-24-51 Oil well TD 3770' 8" @ 1026' Anhy 1020' Heeb 3352' Br. lime 3433' Arb. 3733' DST 3738-55 open 10 min. rec 240' oil TD 3765' 5" @ 3760' DD 3770' S/1½ BOPH 3 hr. 2000 A F/23 BOPH Comp. 782 BOPD COMPLETED

FORM 275 FOR SALE BY KANSAS BLUE PRINT CO.


County Pawnee State Kansas

Sec. 23 (Blk. Twp.) 20 (Sur. Rge.) 16W Map No.

Operator Vickers etal.

Well No. 5 Farm Dirks "A"

Elev. Location SW SE SW

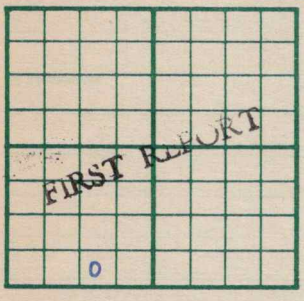

330 Ft. From S Line SW

990 Ft. From E Line Quarter

1st. Report AUG 22 1951

Completion

Remarks

Spudding Date

Drlg. Data Pawnee Rock Pool

Location

J. E. TYRA

FORM 275 FOR SALE BY KANSAS BLUE PRINT CO.

County Pawnee State Kansas

Sec. 23 (Blk. Twp.) 20 (Sur. Rge.) 16W Map No.

Operator Vickers Pet. etal.

Well No. 5 Farm Dirks "A"

Elev. 2022 Location SW SE SW



330 Ft. From S Line SW

990 Ft. From E Line Quarter

1st. Report

Completion OCT 3 1951

Remarks Pawnee Rock Pool

Spudding Date 9-24-51

Drlg. Data Oil well TD 3770

8" @ 1026 Anhy 1020 Heeb. 3352

Br. lime 3433 Arb. 3733 DST 3738-55

open 10 min. Rec. 240' oil TD 3765

5" @ 3760 DD 3770 S/ 1½ boph 3 hr.

2000 A F/ 23 boph Comp. 782 bopd

J. E. TYRA