


Map No. _____ Sec. 36 Twp. 25 R. 8Well No. 8 Bryden Farm _____
Tidal Oil Company _____

NORTH

WEST

EAST

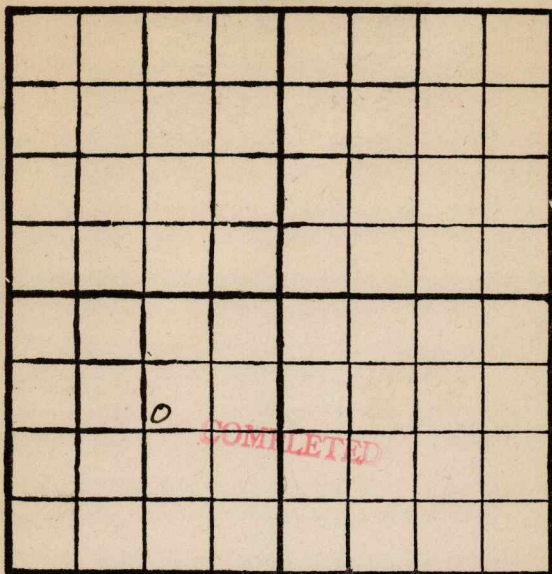

SOUTH

Location _____

Rig Up _____

Drilling Remarks:

Drilling Remarks:

RECORD

Cased _____ in. _____ ft.

Sand _____

Gas _____

Oil _____

Total Depth _____

PRODUCTION

1st 24 hrs. Nat. _____

1st 24 hrs. after shot _____

Gas _____ cu. ft.

Dry Hole _____

Abandoned _____

Map No. K15 Sec. 36 Twp. 25 R. 8Well No. 8 BrydenTidal Oil Company

Contractor _____

NORTH

WEST

EAST

FIRST REPORT

O

SOUTH

825' N

1120 E

Location _____

Rig up _____

Drilling and Remarks:

600'

RECORD

Cased _____ in., _____ ft.

Sand _____

Gas _____

Oil _____

Total Depth _____

PRODUCTION

1st 24 hrs. Nat. _____

1st 24 hrs. after shot _____

Gas _____ Cu. Ft.

Dry Hole _____

Abandoned _____

Date

April 3 1919 Pyle Scout


Map No. K 15 Sec. 36 Twp. 25 R. 8Well No. 8 Bryden
Tidal Oil Company

Contractor

NORTH

WEST

EAST

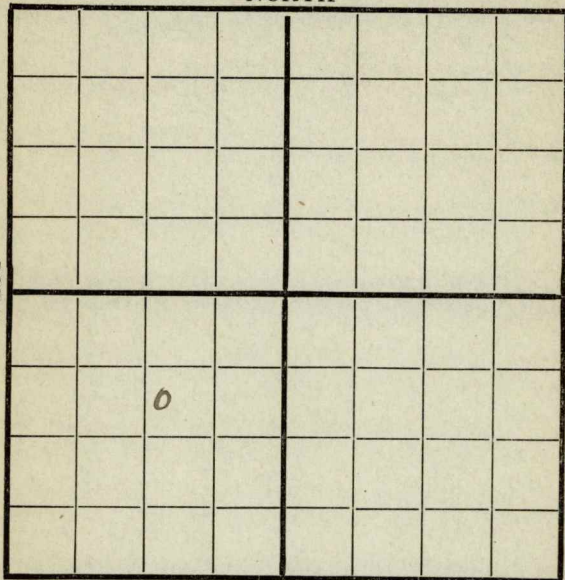

825 N

SOUTH

1120 E

Location _____

Rig up _____

Drilling and Remarks:

RECORD

Cased _____ in., _____ ft.

Sand _____

Gas _____

Oil _____

Total Depth _____

PRODUCTION

1st 24 hrs. Nat. _____

1st 24 hrs. after shot _____

Gas _____ Cu. Ft.

Dry Hole _____

Abandoned _____

Date

1919

Pyle

Scout

Map No. K15 Sec. 36 Twp. 25 R. 8Well No. 8 BrydenTidal Oil Company

Contractor

NORTH

WEST

EAST

825 N

SOUTH

1120 E

Location _____

Rig up _____

Drilling and Remarks:

Shot 100 gts

RECORD

Cased _____ in., _____ ft.

Sand 2287-2333

Gas _____

Oil 2290-2333Total Depth 2335

PRODUCTION

1st 24 hrs. Nat. _____

1st 24 hrs. after shot 80 bbls

Gas _____ Cu. Ft.

Dry Hole _____

Abandoned _____

Date

4/18 1919Cyle Scout