


Section 23 Township 20 Range 16WWell No. #5 Unruh (A)Company Vickers Pet. Co.

NORTH

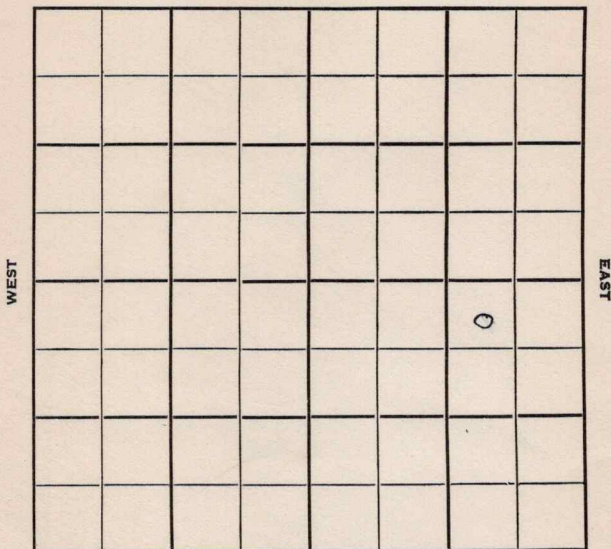

WEST

EAST

SOUTH

Pawnee

Sec. 23 Twp. 20 R. 16W

Well No. #5 Unruh (A) Farm

Vickers Pet. Co. Company

Pawnee Rock

Contractor


330 Ft. from N. Line

Ft. from S. Line

990 Ft. from E. Line

Ft. from W. Line

NW NE SE

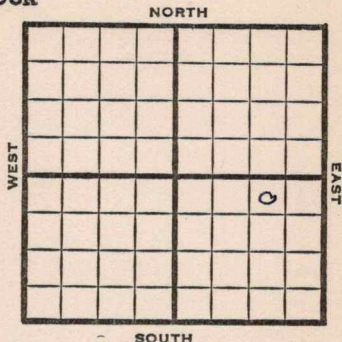

1952

Elev. 2051' REPORT

1/30 Spud 1-28-52
Drlg.

2/6 8" @ 1053
Anhy 1049
Drlg. 2675'

2/13 Heeb 3386' Br li 3466' Simp sd 3759'
Arb. 3762'
DST 3763-74, 15 mins, Est 1 million
gas, 40' GCM, 990# BHP
DST 3780-91 15 mins, Fill up 3750'
HO & GCM, 935# BHP
TD 3791' 5" @ 3790'

2/20 DP DD to 3794 fill up 5 bbl oil
17 hrs.

3/5 F 1½ BOPH

3/11 NR

OVER

1952

753150

3/19 Spud 1-28-52

Oil Well TD 3794

Anhy 1049 8" @ 1053

Heeb. 3386 Br lime 3466

Simp 3759 Arb. 3762

DST 3763-74 opn 15 min.

Rec. 40' gcm 1 M gas

DST 3780-91 opn 15 min.

FU 3750' ho & gcm TD 3791

5" @ 3790 DD 3794

FU 5 bo 17 hr. 500 A

3½ boph F/1½ boph Comp. F/83 bopd

COMPLETED

County **Pawnee** State **Kansas**
Sec. **23** (Blk.) **20** (Sur.) **16W** Map No.

Operator **Vickers Pet. Co.**

Well No. **5** Farm **Unruh (A)**

Elev. Location **NW NE SE**

FIRST REPORT

330 Ft. From **N** Line **SE**

990 Ft. From **E** Line Quarter

1st. Report **JAN 30 1952**

Completion

Remarks

Spudding Date **1-28-52**

Drlg. Data

Pawnee Rock

Drlg.

J. G. McGEHEE

County Pawnee State KansasSec. 23 (Blk.) 20 (Sur.) 16W Map No.Operator Vickers Pet.Well No. 5 Farm Unruh "A"Elev. 2051 Location NW NE SE

330 Ft. From N Line SE990 Ft. From E Line Quarter

1st. Report

Completion MAR 19 1952Remarks Pawnee Rock PoolSpudding Date 1-28-52Drlg. Data Oil well TD 3794Anhy 1049 8" @ 1053 Heeb. 3386Br. lime 3466 Simp. 3759 Arb. 3762DST 3763-74 open 15 min. Rec. 40' gcm1M gas DST 3780-91 open 15 min.FU 3750' ho & gcm TD 3791 5" @ 3790DD 3794 FU..5 bo 17 hr. 500 A3½ boph F/ 1½ boph Comp. F/ 83 boph

J. G. McGEHEE