


Section 23 Township 20 Range 16 WWell No. # 3 Unruh "A"Company Vickers Petroleum

NORTH

WEST

EAST

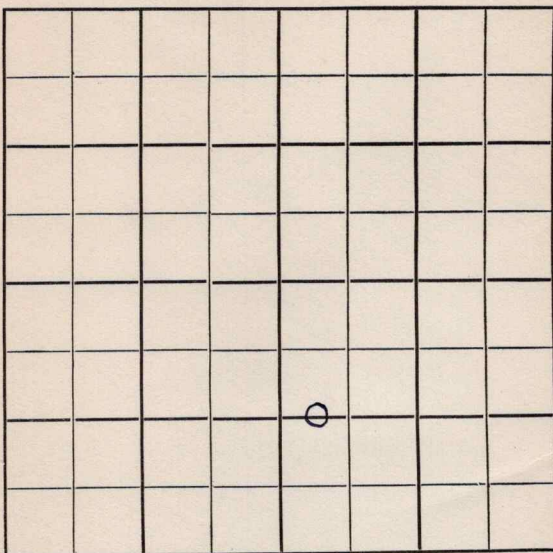

SOUTH

Pawnee

KANSAS

Sec. 23 Twp. 20 R. 16W

Well No. #3 Unruh "A" Farm

Vickers Petroleum Company

Pawnee Rock Pool Contractor


Ft. from N. Line

1320' Ft. from S. Line

Ft. from E. Line

330' Ft. from W. Line

C W L W $\frac{1}{2}$ SE

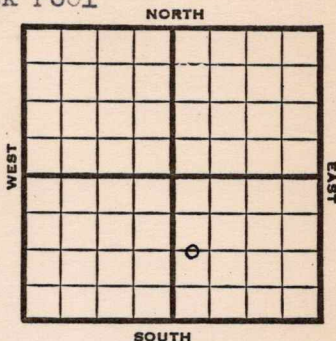

1951

Elev. 2030'

REPORT

5/23

Spud 5-21-51
Drlg. 600'

7/11

Spud 5-21-51
Oil Well TD 3775

Anhy 1030

8" @ 1034

Heeb. 3316

Br Lime 3437

Arb. 3737

DST 3737-50 opn 8 min gas in 1 $\frac{1}{2}$ min

Rec. 30' gem DST 3755-70

opn 10 min. gas in 1 $\frac{1}{2}$ min

Rec. 80' muddy oil TD 3770

5" @ 3766 10 boph DD 3775

Comp. 531 bopd

COMPLETED

County Pawnee State KansasSec. 23 (Blk. Twp.) 20 (Sur. Rge.) 16W Map No.Operator Vickers PetroleumWell No. 3 Farm Unruh "A"Elev. Location C W L W $\frac{1}{2}$ SE1320 Ft. From S Line SE330 Ft. From W Line Quarter1st. Report MAY 23 1951

Completion

Remarks

Spudding Date 5-21-51Drlg. Data Pawnee Rock Pooldrlg. 600

J. E. TYRA

County Pawnee State KansasSec. 23 (Blk.
Twp.) 20 (Sur.
Rge.) 16W Map No.Operator Vickers PetroleumWell No. 3 Farm Unruh "A"Elev. 2030 Location C W L W $\frac{1}{2}$ SE1320 Ft. From S Line SE330 Ft. From W Line Quarter

1st. Report

Completion JUL 11 1951Remarks Pawnee Rock PoolSpudding Date 5-21-51Drlg. Data Oil well TD 3775Anhy 1030 8" @ 1034 Heeb. 3316Br. lime 3437 Arb. 3737DST 3737-50 open 8 min. gas in1 $\frac{1}{2}$ min. Rec. 30' gem DST 3755-70open 10 min. gas in 1 $\frac{1}{2}$ min. Rec.80' muddy oil TD 3770 5" @ 376610 boph DD 3775 Comp. 531 bopd