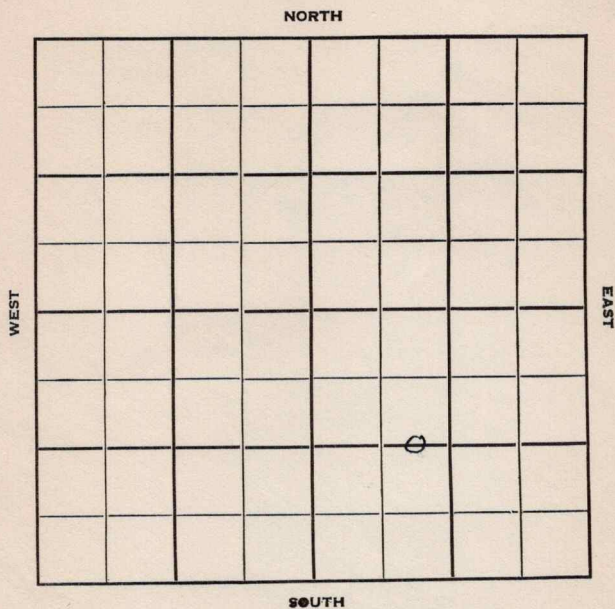


Section 23 Township 20 Range 16WWell No. #4 Unruh(A)Company Vickers Pet.

Pawnee **KANSAS**

Sec. 23 Twp. 20 R. 16 W ✓

Well No. # 4 Unruh (A) Farm

Vickers Pet. Company

Pawnee Rock Contractor


Ft. from N. Line

1320 Ft. from S. Line

Ft. from E. Line

990 Ft. from W. Line

C E/2 W/2 SE

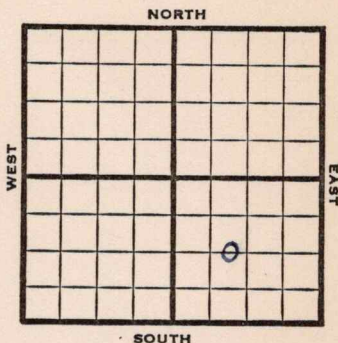

1952 **Elev. 2037'** REPORT

1/16 Spud 1-7-52
Drlg. 900'

2/6 TD 3777 5" @ 3772 POP

2/13 No report

2/20 POP

3/5 Spud 1-7-52

Oil well TD 3778' Anhy 1039'

8" @ 1043 Heeb 3366' Br. lime 3448'

Simp. 3740' Arb. 3745'

DST 3747-58 open 7 min, rec 4,600,000
gas, 30' GCM

DST 3762-74 open 10 min. rec 1 7.10 MCFC

200' oil, 110' HGCO

TD 3777' 5" @ 3772' DD 3778'

S/22 BOPH

Comp. 311 BOPD


COMPLETED

County **Pawnee** State **Kansas**
Sec. **23** (Blk.) **20** (Sur.) **16W** Map No.

Operator **Vickers Pet.**

Well No. **4** Farm **Unruh (A)**

Elev. Location **C E/2 W/2 SE**

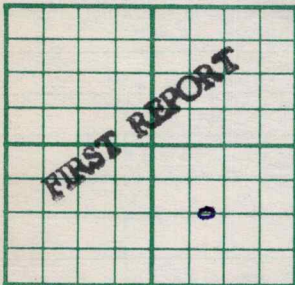

1320 Ft. From **S** Line **SE**

990 Ft. From **W** Line Quarter

1st. Report **JAN 16 1952**

Completion

Remarks

Spudding Date **1-7-52**

Drlg. Data

Pawnee Rock

Drlg. 900

J. E. TYRA

County Pawnee State KansasSec. 23 (Blk.) 20 (Sur.) 16W Map No.Operator Vickers Pet.Well No. 4 Farm Unruh "A"Elev. 2037 Location C E L W $\frac{1}{2}$ SE1320 Ft. From S Line SE990 Ft. From W Line Quarter

1st. Report

Completion MAR 5 1952Remarks Pawnee Rock PoolSpudding Date 1-7-52Drlg. Data Oil well TD 3778Anhy 1039 8" @ 1043 Heeb. 3366Br. lime 3448 Simp. 3740 Arb. 3745DST 3747-58 open 7 min. Rec. 4,600,000gas 30' gcm DST 3762-74 open 10 min.Rec. 1 7.10 mcfg 200' oil 110' hgcoTD 3777 5" @ 3772 DD 3778 S/ 22 bophComp. 311 bopd

J. G. McGEHEE