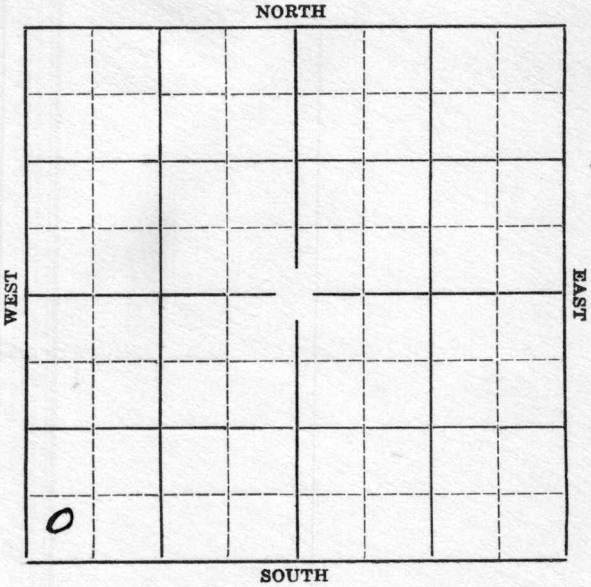


Section 27 Township 20 Range 16-WWell Number #1-GustafsonCompany Kessler et al

Map No. KANSAS Sec. 27 Twp. 20 R. 16W

Well No. #1 Gustafson Farm

Kessler et al Company


 Ft. from N. Line

330' Ft. from S. Line

 Ft. from E. Line

330' Ft. from W. Line

Elev. 2033

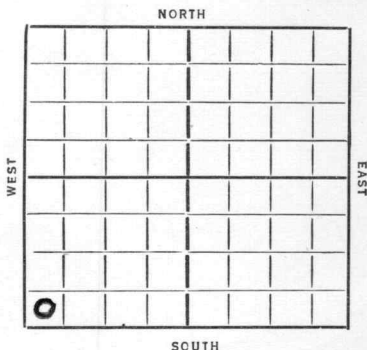

Date
1936

REPORT

6/24 Rigging up.

7/2 -- 7/9---

7/16 Spud.

7/23 Drlg. 160'.

7/30 Drlg. 825'.

8/6 Drlg. 2315'.

8/13 Drlg. 2960'.

7/20 Lansing 3488'. Cored 3555-73'.

Reaming core hole.

8/27 Siliceous 3809'. Water 3834-49'l

Drlg. 4020'.

9/2/36-Sil. 3809'.

T.D. 4140'.

4140' TD in Sil.

Dry and abandoned.

ABANDONED

KANSAS

Map No. 81 Sec. 27 Twp. 20 R. 16W

Well No. 1 Gustafson
Hesseler & Co Company

Contractor

SECTION PLAT

 Ft. from N. Line

330 Ft. from S. Line

 Ft. from E. Line

330 Ft. from W. Line

FIRST REPORT

Location

Rig up

Drilling and Remarks:

Rigging up

RECORD.

Cased in., ft.

Sand

Gas

Oil

Total Depth

PRODUCTION

1st 24 hrs. Nat.

1st 24 hrs. after shot

Gas Cu. Ft.

Dry Hole

Abandoned

Date

JUN 24 1936

19

S. J. LEWIS

Scout

KANSAS

Map No. 81 Sec. 27 Twp. 20 R. 16WWell No. 1 GustafsonKessler & Co. Company

Contractor

SECTION PLAT

0			

 Ft. from N. Line330 Ft. from S. Line Ft. from E. Line330 Ft. from W. Line

ABANDONED

Location Rig up

Drilling and Remarks:

Sil 38094140 ft in SilIVA

RECORD

Cased in., ft.Sand Gas Oil Total Depth 4140

PRODUCTION

1st 24 hrs. Nat. 1st 24 hrs. after shot Gas Cu. Ft.Dry Hole Abandoned

Date

SEP 2 1936 19

S. J. LEWIS Scout