FORM 51 25M 8-50 WESTERN Pawnee KANSAS

Section 23 Township 20 Range 16 W

Well No. # 6 Dirks (A)

Company Vickers & Jayhawk

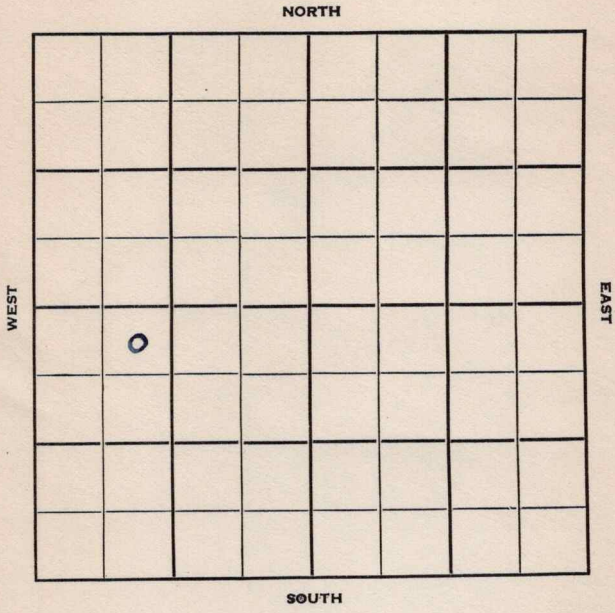

FORM 252-B
10M 10-50 PETROL

Pawnee

KANSAS

Sec. 23 Twp. 20 R. 16W

Well No. #6 Kirks (A) Farm

Vickers & Jayhawk Company

Jayhawk Contractor

330 Ft. from N. Line

Ft. from S. Line

Ft. from E. Line

990 Ft. from W. Line

NE NW SW

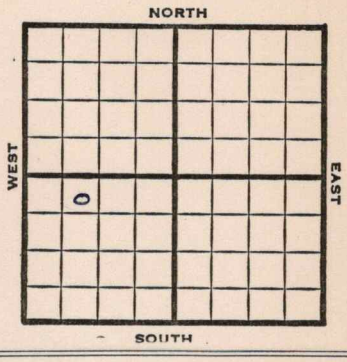

1952	Elev. 2043' REPORT
4/2	RUR
4/9	8" @ 1054 Drlg. 2500'
4/23	Heeb. 3388 Br Li 3468 Arb. 3775 DST 3777-83 RTD 1/4 hr. 210' oil o# 5" @ 3777'
4/30	DP 3783' S/ 5 boph 1000 A
5/7	Spud 4-3-52 Oil Well TD 3783 8" @ 1054 Heeb. 3388 Br Lime 3468 Arb. 3775 DST 3777-83 opn ¼ hr. Rec. 210' oil 5" @ 3777 DP to 3783 S/5 boph 1000 A F/100 bopd

COMPLETED

FORM 275 FOR SALE BY KANSAS BLUE PRINT CO.

County Pawnee State Kansas

Sec. 23 (Blk.) (Twp.) 20 (Sur.) (Rge.) 16W Map No.

Operator Vickers & Jayhawk

Well No. 6 Farm Dirks (A)

Elev. Location NE NW SW

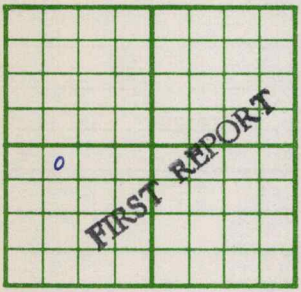

330 Ft. From N Line SW

990 Ft. From W Line Quarter

1st. Report APR 2 1952

Completion

Remarks

Jayhawk - Contr.

Spudding Date

Drlg. Data Pawnee Rock

RUR

J. G. McGEHEE

FORM 275 FOR SALE BY KANSAS BLUE PRINT CO.

County Pawnee State Kansas

Sec. 23 (Blk. Twp.) 20 (Sur. Rge.) 16W Map No.

Operator Vickers & Jayhawk Drlg.

Well No. 6 Farm Dirks "A"

Elev. 2043 Location NE NW SW

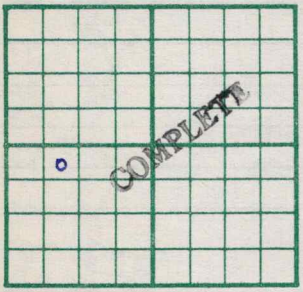

330 Ft. From N Line SW

990 Ft. From W Line Quarter

1st. Report

Completion MAY 7 1952

Remarks Pawnee Rock Pool

Jayhawk Drlg. - Contr.

Spudding Date 4-3-52

Drlg. Data Oil well TD 3783

8" @ 1054 Heeb. 3388 Br. lime 3468

Arb. 3775 DST 3777-83 open ¼ hr.

Rec. 210' oil 5" @ 3777 DP to 3783

S/ 5 boph 1000 A F/ 100 bopd

J. G. McGEHEE