

KANSAS


Sedgwick

FORM 51 5M 1-42 PETROL

Section 24 Township 25 Range 2 E

Well No. #1 B. W. Blackford

Company Texas

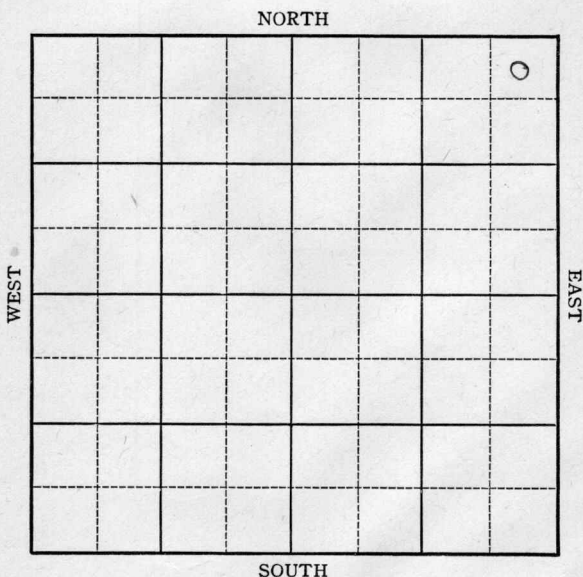

KANSAS

Sedgwick

Sec. 24 Twp. 25 R. 2E

Well No. #1 B.W.Blackford Farm

Texas Company


Wildcat

330 Ft. from N. Line

Ft. from S. Line

330 Ft. from E. Line

Ft. from W. Line

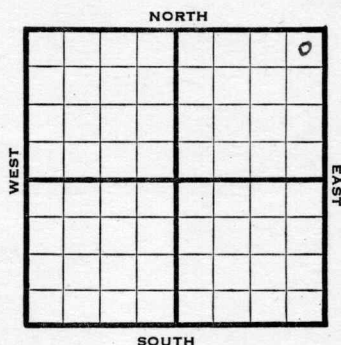

1944

REPORT

5/10 Loc

5/17 Rotary

5/ 24 8" @ 269
Drlg. 1645

5/31 Chat 2520
Drlg. 2840

6/7 3388 fsg.
6/21 Viola 3206
Arb. 3347
T.D. 3375

ABANDONED

KANSAS

Pool Name WildcatMap No. 13 Sec. 24 Twp. 25 R. 2EWell No. 1 B. W. BlackfordTexas


Company

FIRST REPORT

Contractor

NE/C

SECTION PLAT

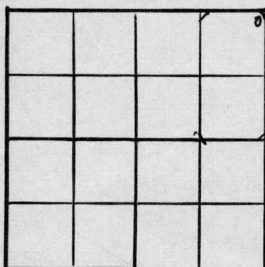330 Ft. from N. Line Ft. from S. Line330 Ft. from E. Line Ft. from W. LineSedgwick CountyLocation XRig up

Drilling and Remarks:

RECORD

Cased in., ft.Sand Gas Oil Total Depth

PRODUCTION

1st 24 hrs. Nat. 1st 24 hrs. after shot Gas Cu. Ft.Dry Hole Abandoned

Date

MAY 10 1944 19S. J. LEWIS Scout

Pool Name Wildcat

KANSAS

Map No. 13 Sec. 24 Twp. 25 R. 2EWell No. 1 B. W. BlackfordTexas

Company

ABANDONED

Contractor

NE/C


SECTION PLAT

330 Ft. from N. Line

Ft. from S. Line

330 Ft. from E. Line

Ft. from W. Line

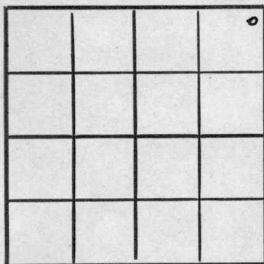Sedgwick County

Location

Rig up

Drilling and Remarks:

*Viola 3206**Cr 73347*

RECORD

Cased _____ in., _____ ft.

Sand _____

Gas _____

Oil _____

Total Depth 3925

PRODUCTION

1st 24 hrs. Nat. _____

1st 24 hrs. after shot _____

Gas _____ Cu. Ft.

Dry Hole _____

Abandoned _____

Date

JUN 21 1944 19S. J. LEWIS Scout