


Map No. \_\_\_\_\_ Sec. 36 Twp. 25 R. 8  
 Well No. 9 Brydens Farm \_\_\_\_\_  
Mid-Kansas Company \_\_\_\_\_

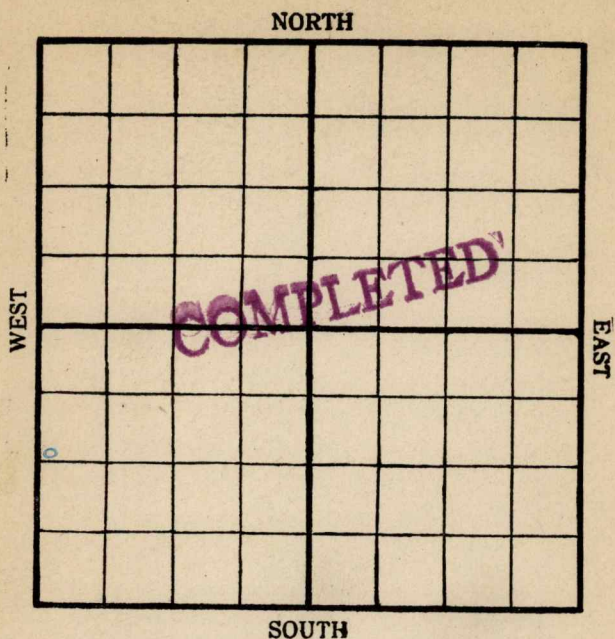

Location \_\_\_\_\_

Rig Up \_\_\_\_\_

Drilling Remarks:

Drilling Remarks:

\_\_\_\_\_  
 \_\_\_\_\_  
RECORD

PRODUCTION

Cased \_\_\_\_\_ in. \_\_\_\_\_ ft.  
 Sand \_\_\_\_\_  
 Gas \_\_\_\_\_  
 Oil \_\_\_\_\_  
 Total Depth \_\_\_\_\_

1st 24 hrs. Nat. \_\_\_\_\_  
 1st 24 hrs. after shot \_\_\_\_\_  
 Gas \_\_\_\_\_ cu. ft.  
 Dry Hole \_\_\_\_\_  
 Abandoned \_\_\_\_\_

Map No. K15 Sec. 36 Twp. 25 R. 8  
 Well No. 9 Bryden  
Mid-Kansas Company  
 Contractor

NORTH

|  |  |  |  |  |  |  |  |
|--|--|--|--|--|--|--|--|
|  |  |  |  |  |  |  |  |
|  |  |  |  |  |  |  |  |
SOUTH

WEST

EAST

FIRST REPORT

|                                            | RECORD                       |
|--------------------------------------------|------------------------------|
| Location _____                             | Cased _____ in., _____ ft.   |
| Rig up <input checked="" type="checkbox"/> | Sand _____                   |
| Drilling and Remarks:                      | Gas _____                    |
|                                            | Oil _____                    |
|                                            | Total Depth _____            |
|                                            | <b>PRODUCTION</b>            |
|                                            | 1st 24 hrs. Nat. _____       |
|                                            | 1st 24 hrs. after shot _____ |
|                                            | Gas _____ Cu. Ft.            |
|                                            | Dry Hole _____               |
|                                            | Abandoned _____              |

Date 7/13 1918 Cyle Scout

Map No. \_\_\_\_\_ Sec. 36 Twp. 25 R. 8Well No. 9 BrydenMid. Kansas Company

Contractor \_\_\_\_\_

NORTH

WEST

EAST

SOUTH

Location \_\_\_\_\_

Rig up \_\_\_\_\_

Drilling and Remarks:

*Spudding*

## RECORD

Cased \_\_\_\_\_ in., \_\_\_\_\_ ft.

Sand \_\_\_\_\_

Gas \_\_\_\_\_

Oil \_\_\_\_\_

Total Depth \_\_\_\_\_

## PRODUCTION

1st 24 hrs. Nat. \_\_\_\_\_

1st 24 hrs. after shot \_\_\_\_\_

Gas \_\_\_\_\_ Cu. Ft.

Dry Hole \_\_\_\_\_

Abandoned \_\_\_\_\_

Date

7/18 1918 *Cyle* Scout



Map No. \_\_\_\_\_ Sec. 36 Twp. 25 R. 8Well No. 9 Brydenmi. Kansas Company \_\_\_\_\_

Contractor \_\_\_\_\_

NORTH

WEST

EAST

SOUTH

Location \_\_\_\_\_

Rig up \_\_\_\_\_

Drilling and Remarks:

## RECORD

Cased \_\_\_\_\_ in., \_\_\_\_\_ ft.

Sand \_\_\_\_\_

Gas \_\_\_\_\_

Oil \_\_\_\_\_

Total Depth \_\_\_\_\_

## PRODUCTION

1st 24 hrs. Nat. \_\_\_\_\_

1st 24 hrs. after shot \_\_\_\_\_

Gas \_\_\_\_\_ Cu. Ft.

Dry Hole \_\_\_\_\_

Abandoned \_\_\_\_\_

Date


7/27 1918 Oyle Scout

Map No. \_\_\_\_\_ Sec. 36 Twp. 25 R. 8Well No. 9 BrydenMid-Kansas Oil Company

Contractor \_\_\_\_\_

NORTH

WEST

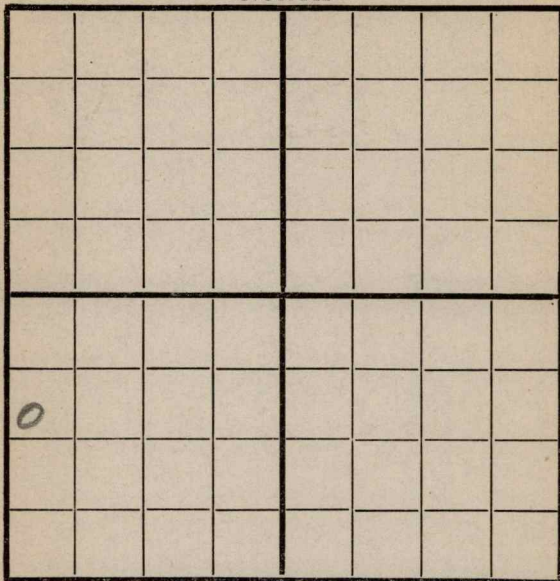

EAST

SOUTH

Location 200' WRig up 1120' N

Drilling and Remarks:

10' @ 1160'

## RECORD

Cased \_\_\_\_\_ in., \_\_\_\_\_ ft.

Sand \_\_\_\_\_

Gas \_\_\_\_\_

Oil \_\_\_\_\_

Total Depth \_\_\_\_\_

## PRODUCTION

1st 24 hrs. Nat. \_\_\_\_\_

1st 24 hrs. after shot \_\_\_\_\_

Gas \_\_\_\_\_ Cu. Ft.

Dry Hole \_\_\_\_\_

Abandoned \_\_\_\_\_

Date

8/3 1918 C. G. L. Scout

Map No. \_\_\_\_\_ Sec. 36 Twp. 25 R. 8Well No. 9 BrydenMid-Kansas Company

Contractor \_\_\_\_\_

NORTH

WEST

EAST

SOUTH

Location 200 W  
1120 N

Rig up \_\_\_\_\_

Drilling and Remarks:

1550'

## RECORD

Cased \_\_\_\_\_ in., \_\_\_\_\_ ft.

Sand \_\_\_\_\_

Gas \_\_\_\_\_

Oil \_\_\_\_\_

Total Depth \_\_\_\_\_

## PRODUCTION

1st 24 hrs. Nat. \_\_\_\_\_

1st 24 hrs. after shot \_\_\_\_\_

Gas \_\_\_\_\_ Cu. Ft.

Dry Hole \_\_\_\_\_

Abandoned \_\_\_\_\_

Date

8/5 1918 Cyle Scout

Map No. K15 Sec. 36 Twp. 25 R. 8  
Well No. 9 Bryden  
Mid-Kansas Company \_\_\_\_\_  
Contractor \_\_\_\_\_

NORTH

|      |  |  |  |  |  |  |  |  |  |      |
|------|--|--|--|--|--|--|--|--|--|------|
| WEST |  |  |  |  |  |  |  |  |  | EAST |
|      |  |  |  |  |  |  |  |  |  |      |
|      |  |  |  |  |  |  |  |  |  |      |
SOUTH

COMPLETED

11207N  
2007W

|   |   |
|---|---|
| Location <u>2007W</u><br>Rig up _____<br>Drilling and Remarks:<br><u>Shot 120 gts</u><br><u>Est 50 bbl</u> | <b>RECORD</b><br>Cased _____ in., _____ ft.<br>Sand <u>2293-2385</u><br>Gas _____<br>Oil _____<br>Total Depth _____<br><br><b>PRODUCTION</b><br>1st 24 hrs. Nat. _____<br>1st 24 hrs. after shot _____<br>Gas _____ Cu. Ft.<br>Dry Hole _____<br>Abandoned _____ |
|---|---|

Date 8/17 1918 Gyle Scout