

Sec. 29 Twp. 20 R. 16W

Well No. #1 Fox Farm _____

Imperial Pet. Company _____

Imperial
Wildcat. Contractor _____


_____ Ft. from N. Line

330 Ft. from S. Line

990 Ft. from E. Line

_____ Ft. from W. Line

SW SE SE

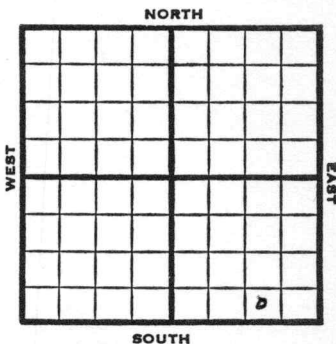

1953 Elev. 2028' REPORT

7/1 Spud 6-21-53
 8" @ 315'
 Anhy 1050'
 Drlg 3320'

7/8 Spud 6-21-53
 D&A
 TD 4837
 8" @ 315
 Anhy 1050, Heeb 3391, Lans 3482,
 B KC 3702, Arb. 3787
 DST 3789-93, opn 1 hr., rec. 40'
 sul. wtr., 910#,
 DST 3804-11, opn 1 hr., rec. 474' SW
 1070#,
 TD 4837
 D&A

ABANDONED

