

Butler


KANSAS

Form 51-5M 5-37 Petrol

Section 1 Township 25 Range 3-E

Well No. 2 - Houston

Company Phillips Pet.

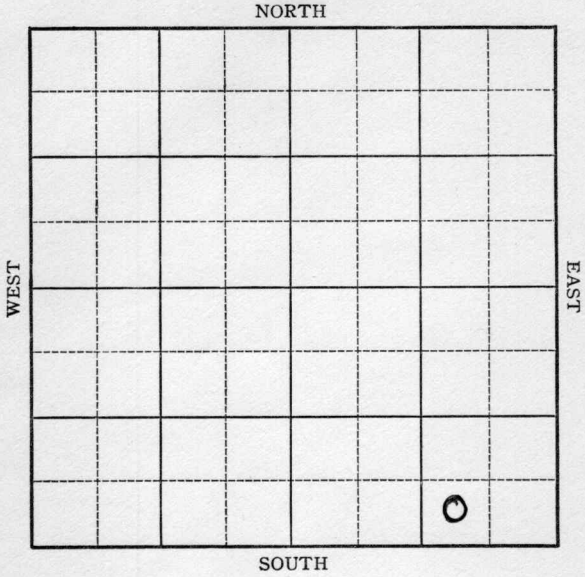

Sec. 1 Twp. 25 R. 3-E


Well No. #2 Houston Farm  
Phillips Pet. Company

\_\_\_\_\_ Ft. from N. Line

330 Ft. from S. Line

990 Ft. from E. Line

\_\_\_\_\_ Ft. from W. Line

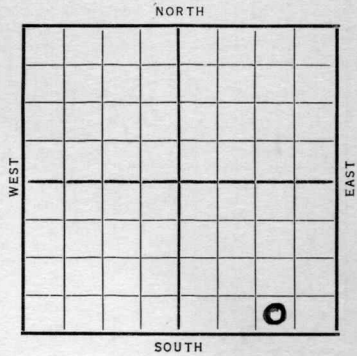

Date	REPORT
1937	
6/9	12" @ 43'.
	Drlg. 665'.
6/19	10" @ 1180'. WOC.
6/25	8" @ 1837'. Drlg. 1875'.
7/2	6" @ 2350'. Drlg. 2640'.
7/9	K.C. 2205'. Miss. 2665'.
	5" @ 2670'. T.D. 2685'.
7/16	" " " "
7/23	Shot 5 qts. C.O.
7/28	Miss 2654'
	Cong 2667' (corrected)
	TD 2685'
	5" @ 2670'
	Shot 5 qts.
	3000 acid
	Pot 10 bbls oil & 10 water.
	COMPLETED

*Butler* KANSAS

Map No. 13 Sec. 1 Twp. 25 R. 3 <sup>E</sup>

Well No. 2-Houston

Phillips Pet Company

(Use did belong To Sheldon) Contractor

**FIRST REPORT**

**SECTION PLAT**

\_\_\_\_\_ Ft. from N. Line

330 Ft. from S. Line

990 Ft. from E. Line

\_\_\_\_\_ Ft. from W. Line

			0

Location \_\_\_\_\_

Rig up \_\_\_\_\_

Drilling and Remarks:

*12" - 43*  
*Dlg 665*

**RECORD**

Cased \_\_\_\_\_ in., \_\_\_\_\_ ft.

Sand \_\_\_\_\_

Gas \_\_\_\_\_

Oil \_\_\_\_\_

Total Depth \_\_\_\_\_

**PRODUCTION**

1st 24 hrs. Nat. \_\_\_\_\_

1st 24 hrs. after shot \_\_\_\_\_

Gas \_\_\_\_\_ Cu. Ft.

Dry Hole \_\_\_\_\_

Abandoned \_\_\_\_\_

Date

**JUN 9 1937** 19

**H. D. Hatfield** Scout

Butler KANSAS

Map No. 13 Sec. 1 Twp. 25 R. 3E

Well No. 2-Houston

Phillips Pet Company

Contractor

COMPLETED

\_\_\_\_\_ Ft. from N. Line

330 Ft. from S. Line

990 Ft. from E. Line

\_\_\_\_\_ Ft. from W. Line

SECTION PLAT

			0

Location \_\_\_\_\_

Rig up \_\_\_\_\_

Drilling and Remarks:

Shot 5 gals  
3000 Acid

Prod 10 bbls oil  
10 ✓ water

RECORD

Cased 5 in., 2670ft.

Sand MISS 2654  
cong 2667

Gas \_\_\_\_\_  
(corrected)

Oil \_\_\_\_\_

Total Depth 2685

PRODUCTION

1st 24 hrs. Nat. \_\_\_\_\_

1st 24 hrs. after shot \_\_\_\_\_

Gas \_\_\_\_\_ Cu. Ft.

Dry Hole \_\_\_\_\_

Abandoned \_\_\_\_\_

Date

JUL 28 1917

H. D. Hatfield

Scout