


Section 26 Township 20 Range 16WWell No. #6 SeibertCompany G M R Oil

NORTH

WEST

EAST

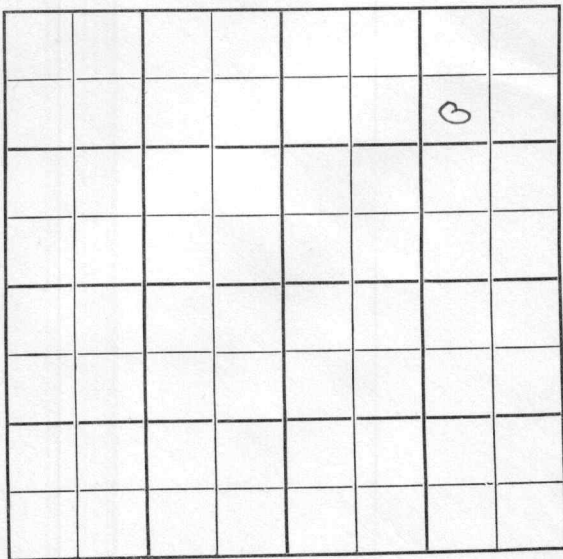

SOUTH

Pawnee

KANSAS

Sec. 26 Twp. 20 R. 16WWell No. #6 Seibert FarmG-M-R Oil

Company

G-M-R

Contractor

Pawnee Rock Pool

990


Ft. from N. Line

Ft. from S. Line

990

Ft. from E. Line

Ft. from W. Line

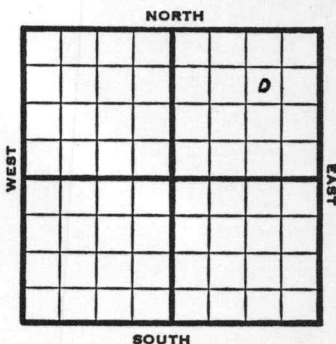NE $\frac{1}{4}$ SW NE NE

1952

Elev. 2041'

REPORT

11/5

Spud 10-31-52

8" @ 205'

Anhy 1040'

Drlg. 2662'

11/12

Br 11 3464'

Lans. 3474'

Simp 3766'

Arb. 3770'

RTD 3779'

5" @ 3776'

11/19

Spud 10-31-52

Oil well TD 3782' 8" @ 205'

Anhy 1040' Br. lime 3464'

Lans. 3474'

Simp. 3766'

Arb. 3770'

TD 3779' 5" @ 3776 CO to 3779'

5 BOPH $1\frac{1}{2}$ MCFG DD 3782' 15 BOPH $1\frac{1}{2}$ MCFG

Comp. 75 BOPD


COMPLETED

County **Pawnee** State **Kansas**
 Sec. **26** (Blk. Twp.) **20** (Sur. Rge.) **16W** Map No.

Operator **G-M-R Oil**

Well No. **6** Farm **Seibert**

Elev. Location **SW NE NE**

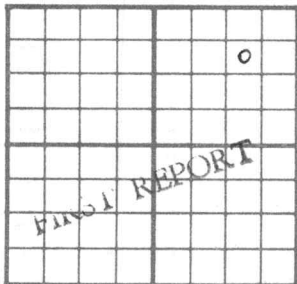

990 Ft. From **N** Line **NE**

990 Ft. From **E** Line Quarter

1st. Report **NOV 5 1952**

Completion

Remarks

G-M-R - Contr.


Spudding Date **10-31-52**

Drlg. Data

Pawnee Rock Pool

8" @ 205 Anhy 1040 drlg. 2662

J. G. McGEHEE

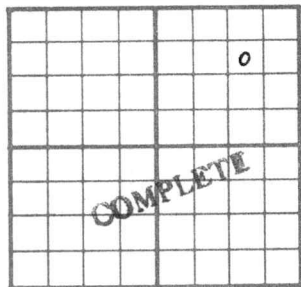County Pawnee State KansasSec. 26 (Blk. 20 (Sur. 16W Map No.)
(Twp.) (Rge.)Operator G-M-R OilWell No. 6 Farm SeibertElev. 2041 Location SW NE NE990 Ft. From N Line NE990 Ft. From E Line Quarter1st. Report Completion NOV 19 1952Remarks Pawnee Rock PoolG-M-R - Contr.Spudding Date 10-31-52Drlg. Data Oil well TD 37828" @ 205 Anhy 1040 Br. lime 3464Lens. 3474 Simp. 3766 Arb. 3770TD 3779 5" @ 3776 CO to 37795 boph 1 $\frac{1}{2}$ mcf/g DD 3782 15 boph 1 $\frac{1}{2}$ mcf/gComp. 75 bopd

J. G. McGEHEE