

Section 28 Township 20 Range 16 WWell No. # 1 FleskeCompany Iron Drlg.

NORTH

0							

WEST

EAST

SOUTH

Pawnee

KANSAS

Sec. 28 Twp. 20 R. 16 W ✓

Well No. # 1 Fleske Farm

Iron Drlg. Company

Contractor

Wildcat

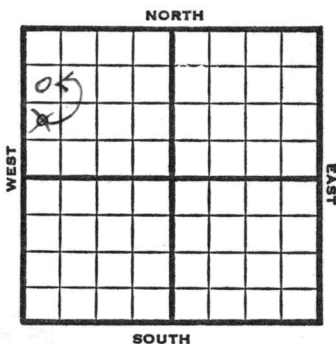
990 Ft. from N. Line

990 Ft. from S. Line

Ft. from E. Line

330 Ft. from W. Line

SW NW
NW SW NW



1951

Elev. 2075'

REPORT

4/11

Spud 4-4-51

8" @ 805

Anhy 1098-1133'

Drlg. 2322'

4/25

Spud 4-4-51

D&A TD 3943

8" @ 805

Anhy 1098-1133

Heeb. 3446

Lans. 3528

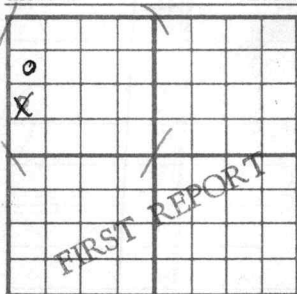
Cong. 3839

Simp 3893

Arb. 3904

TD 3943 D&A

ABANDONED

County Pawnee State KansasSec. 28 (Blk.) 20 (Sur.) 16W Map No.Operator Iron Drlg.Well No. 1 Farm FleskeElev. Location SW NW NW
NW SW NW990 Ft. From N Line NW330 Ft. From W Line Quarter1st. Report APR 11 1951

Completion

Remarks

Spudding Date 4-4-51Drlg. Data Wildcat8" @ 805 Anhy 1098-1133 drlg. 2322

see correction
attached

J. E. TYRA

Map No. _____ Sec. 28 Twp. 20 R. 16WWell No. 1 Fleske

Iron Drllg.

Company _____

CORRECTION

Contractor _____

SW NW NW

SECTION PLAT

0			

990 Ft. from N. Line

_____ Ft. from S. Line

_____ Ft. from E. Line

330 Ft. from W. Line

Pawnee County

Location _____

Rig up _____

Drilling and Remarks:

Reported

NW SW NW

RECORD

Cased _____ in., _____ ft.

Sand _____

Gas _____

Oil _____

Total Depth _____

PRODUCTION

1st 24 hrs. Nat. _____

1st 24 hrs. after shot _____

Gas _____ Cu. Ft.

Dry Hole _____

Abandoned _____

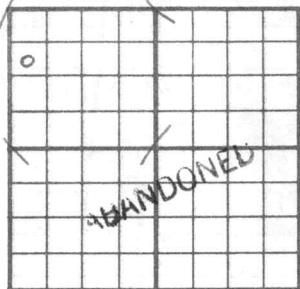
Date

APR 18 1951

19

J. E. TYRA

Scout

County Pawnee State KansasSec. 28 (Blk. 20 (Sur. 16W Map No.Operator Iron Drlg.Well No. 1 Farm FleskeElev. 2075 Location SW NW NW990 Ft. From N Line NW330 Ft. From W Line Quarter

1st. Report

Completion APR 25 1951Remarks WildcatSpudding Date 4-4-51Drlg. Data D & A TD 39438" @ 805 Anhy 1098-1133 Heeb. 3446Lans. 3528 Cong. 3839 Simp. 3893Arb. 3904-43 TD D & A