


Section 30 Township 20 Range 16WWell No. #1 Schmidt "A"Company Helmerich & Payne

Wildcat

NORTH

WEST

EAST

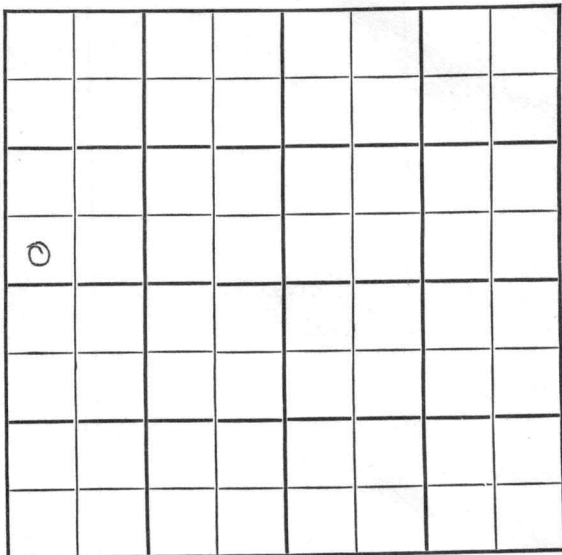

SOUTH

Pawnee ✓

Sec. 30 **KANSAS** Twp. 20 R. 16W

Well No. #1 Schmidt "A" Farm

Helmerich & Payne Company

Wildcat


_____ Ft. from N. Line

330' Ft. from S. Line

_____ Ft. from E. Line

330' Ft. from W. Line

SW NW

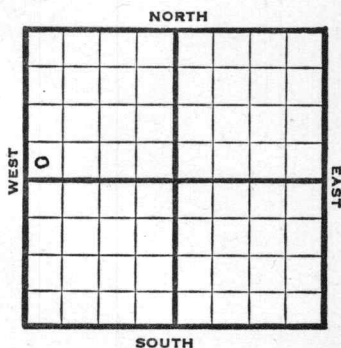

1948

Elev. 2037' REPORT

2/11 RUR

2/18 8" @ 1005'
WOC

2/ 25 Drlg. 3425'

3/3 Arbuckle 3863'
Total Depth 3965'

ABANDONED

Map No. _____ Sec. 30 Twp. 20 R. 16W

Well No. 1 Schmidt "A"

Helmerich & Payne Company

FIRST REPORT

Contractor

SW NW

SECTION PLAT

_____ Ft. from N. Line

330 Ft. from S. Line

_____ Ft. from E. Line

330 Ft. from W. Line

0			

Pawnee County

Location _____

Rig up _____

Drilling and Remarks:

R U R

RECORD

Cased _____ in., _____ ft.

Sand _____

Gas _____

Oil _____

Total Depth _____

PRODUCTION

1st 24 hrs. Nat. _____

1st 24 hrs. after shot _____

Gas _____ Cu. Ft.

Dry Hole _____

Abandoned _____

Date

FEB 11 1948

19

S. J. LEWIS

Scout

Map No. 81 Sec. 30 Twp. 20 R. 16W

Well No. 1 Schmid "A"

Helmerich & Payne Company

ABANDONED

Contractor

SW NW

E 12007
SECTION PLAT

 Ft. from N. Line

330 Ft. from S. Line

 Ft. from E. Line

330 Ft. from W. Line

Pawnee County

Location

Rig up

Drilling and Remarks:

See 8082

RECORD

Cased in., ft.

Sand

Gas

Oil

Total Depth 8965

PRODUCTION

1st 24 hrs. Nat.

1st 24 hrs. after shot

Gas Cu. Ft.

Dry Hole

Abandoned

Date

MAR 3 1948 19

S. J. LEWIS

Scout