


Map No. _____ Sec. 36 Twp. 25 R. 8

Well No. 11 Bryden Farm _____
Tidal & Southern Company

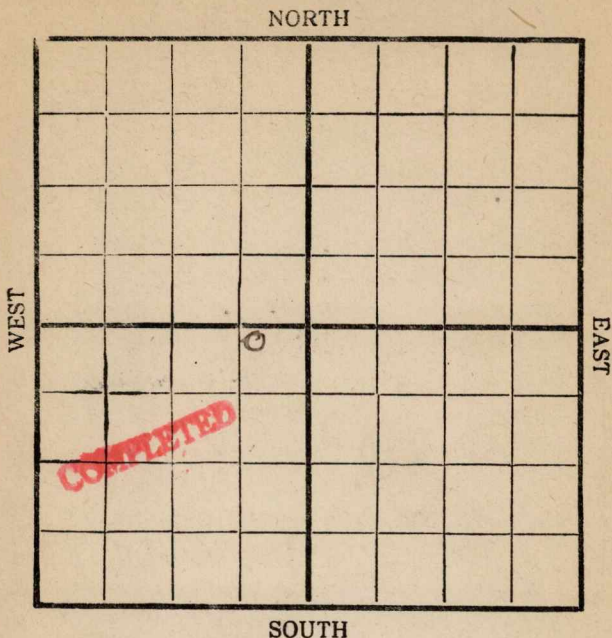

Location _____

Rig Up _____

Drilling Remarks:

Drilling Remarks:

Shot 40 gts

RECORD

PRODUCTION

Cased _____ in. _____ ft.

1st 24 hrs. Nat. _____

Sand 2315-2356

1st 24 hrs. after shot 30 gal

Gas _____

Gas _____ cu. ft.

Oil _____

Dry Hole _____

Total Depth _____


Abandoned _____

Map No. K15 Sec. 36 Twp. 25 R. 8

Well No. 11 Bryden
Tidal & Southern Company

Contractor

NORTH

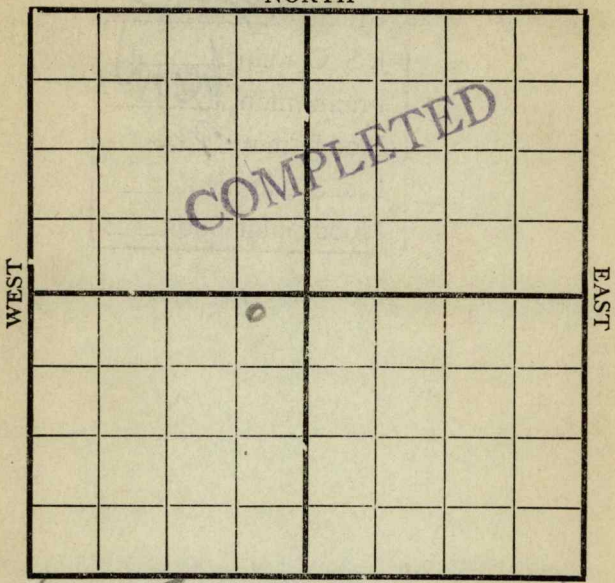

610 E

SOUTH

250 N

Location _____

Rig up _____

Drilling and Remarks:

Shot 40 qts

RECORD

Cased _____ in., _____ ft.

Sand 2315 - 2356

Gas _____

Oil _____

Total Depth _____

PRODUCTION

1st 24 hrs. Nat. _____

1st 24 hrs. after shot 30 bbls

Gas _____ Cu. Ft.

Dry Hole _____

Abandoned _____

Date

8/7 1919

Pyle Scout