


DX 78-1 GREENWOOD

KANSAS

Section 36 Township 25 Range 8E

Well No. 26 Bryden

Company Tidewater Oil

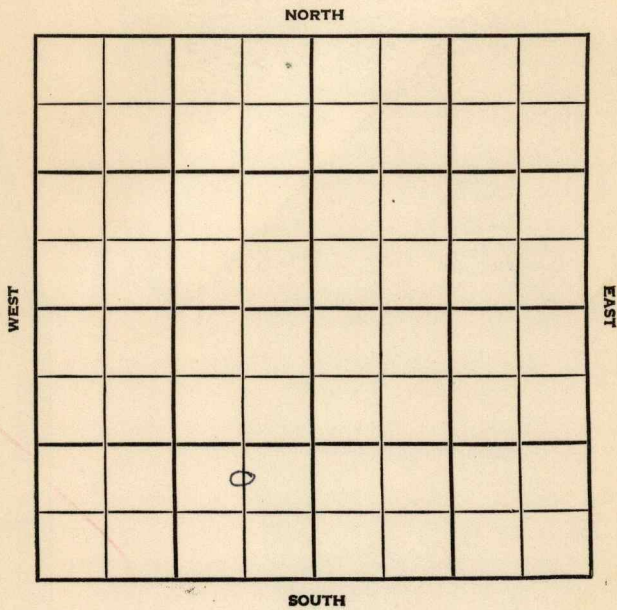

**Greenwood KANSAS**

SEC.	TWP.	R.
36	25	8E

WELL NO. \_\_\_\_\_

**26 Bryden** FARM

COMPANY \_\_\_\_\_

**Tidewater Oil**

CONTRACTOR \_\_\_\_\_

**White & Ellis**


**Sallyards Pool**

\_\_\_\_\_ Ft. from N. Line

**1020** \_\_\_\_\_ Ft. from S. Line

**666** \_\_\_\_\_ Ft. from E. Line

\_\_\_\_\_ Ft. from W. Line

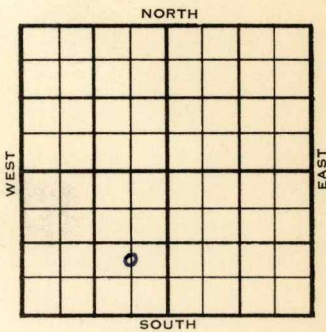

**C N/2 SE SW**

	ELEVATION	REPORT
1955	<b>1279'</b>	

3/30 **Bart 2300'**  
 TD 2330'  
 5" @ 2300', WOC

5/25 **Btv 2300; TD 2361; RTD 2330;**  
 5" 2300; bail 2¼ bo plus 3¼ bw  
 24 hrs; pmp 25 bopd plus 4 BWPD from  
 Btv 2300-51

**COMPLETED**

County **Greenwood** State **Kansas**

Sec. **36** (Blk. Twp.) **25** (Sur. Rge.) **8E** Map No.

Operator **Tidewater Oil**

Well No. **26** Farm **Bryden**

Elev. **1279** Location **C N $\frac{1}{2}$  SE SW**


**FIRST REPORT**

**1020** Ft. From **S** Line **SW**

**666** Ft. From **E** Line Quarter

Ist. Report **MAR 30 1955**

Completion

Remarks

**White & Ellis - Contr.**

Spudding Date

Drlg. Data **Sallyards Pool**

**Bart. 2300 TD 2330 5" @ 2300 WOC**

**FABEN GILSTRAP**