

Sedgwick

KANSAS

SECTION 3 TOWNSHIP 25 RANGE 2E

WELL NO. #1 DuBois


COMPANY Renfro Drlg.

NORTH

*C N 2 SE NW*  
~~SW NE NW~~

WEST

EAST

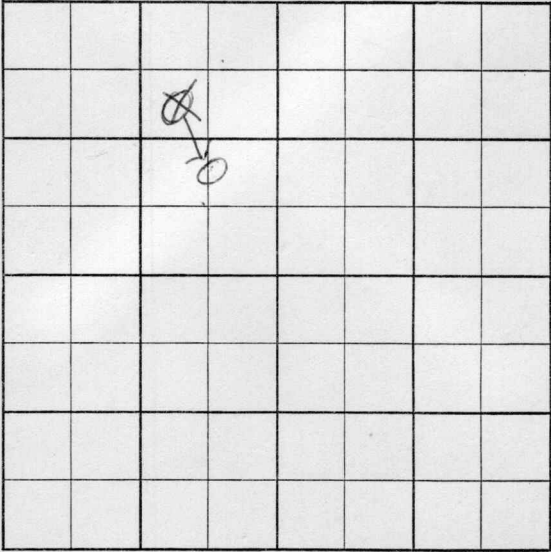

SOUTH

29

# WILDCAT

FORM 513 SUNRAY

County Sedgwick Elev. 1370  
 Sec. 3 Twp. 25 Rge. 2 E  
 Company Renfro Drlg.  
 Farm Name DuBois No. 1

TOPS	DEPTH	LOG	DATUM
Anh.			
TP.			
H.			
Tr.			
Dg.			
Bl.			
L.			
K.C.			
B.K.C.			
Ce.			
C.			
M.			
M.			
K.			
Mz.			
Me.			
V.			
S.			
S.			
A.			
R.			
Pe.			
G.			
T.D.			

Loc. in Sec. SW NE NW  
 Geol. \_\_\_\_\_  
 Contr. Renfro  
 Pool Wildcat



Date Comm. 9-8-57  
8" @ 160/200 drlg. 1700

Co. No. Sec. T. R.

~~29~~  
CORRECTION

FORM 513 SUNRAY

County Sedgwick Elev. 1370  
 Sec. 3 Twp. 25 Rgs. 2 E  
 Company Renfro Drlg.  
 Farm Name DuBois No. 1

	TOPS	DEPTH	LOG	DATUM
Anh.				
Tr.				
H.				
Tr.				
Dg.				
BL.				
L.				
K.C.		2384	2385	
B.K.C.		2560	2563	
<del>C.</del> <u>Burg St</u>		2829	2829	
C.				
M.		2880	2868	
M. <u>HT</u>		3233	3235	
K.		3143	3157	
Mz.				
Mq.				
V.		3294	<del>3291</del> 3298	
S.		3320	3320	
S.				
A.		3398	3401	
R.				
Pe.				
G.				
T.D.		3410		

Loc. in Sec. SW 1/4 NW 25 1/2 SE 2nd

Geol. \_\_\_\_\_  
 Contr. Renfro

Pool DUBOIS  
DISCOVER  
~~WATER~~

NOV 6 '57

COMPLETE

Date Comm. 9-8-57

8" @ 160/200 drlg. 1700 SEP 18 57 X

DST 2831-45 1 hr. 1680' oil  
60' mw 7P/300-752 BHP/920  
DST 2852-59 1 hr. 1450' sw  
 7P 64-700 BHP/ 902/200 3310  
 Ranlog 8" 2940/150 WOC T  
 CO 24/2930-34 NS  
12/2836-38 FU 800' 0 NW 2 1/2  
 hrs B 259 fresh water from  
 Bottom

FU 2500<sup>1</sup> 0 12 hrs 00 Nat

OCT 10 57

2530 pd nw

OCT 16 57

OCT 23 57

OCT 30 57

PHY 5730 pd + 2070w  
40° gw

Bugsd 2830-38

TD 3410

NOV 9 57

3-25-2E

CN/2 se nw