


Bulle

Map No. KANSAS Sec. 31 Twp. 26 R. 6

Well No. 1 - Muger Farm
O.V. Paul et al Company

..... Ft. from N. Line
250 Ft. from S. Line
660 Ft. from E. Line
..... Ft. from W. Line

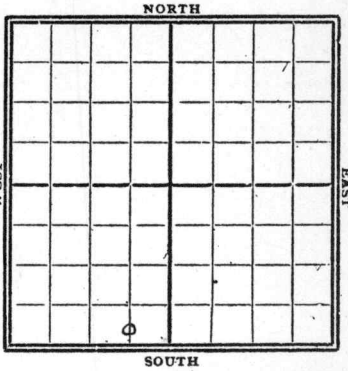

1928

Date

REPORT

10/17	Rig up.
10/24	
10/31	Spudding
11/7	Spdy 100'
11/14	Drily 800'
11/21	" 1200'
11/28	10" - 1605'
12/15	Drily 2000'
12/12	HFW 2235' Drily 2300'
12/19	drily 2400'
12/26	" 2590'
1929	
1/2	No sand
	Top line 2772'
	TD 2804'
	dry & Abandoned

Butler

K14 KANSAS MAP NO. _____ SEC. 31 TWP. 26 R. 6

WELL NO. 1 Minger
D. V. Paul et al COMPANY _____

CONTRACTOR _____

FIRST REPORTS

SECTION PLAT

_____ FT. FROM N. LINE
 250 FT. FROM S. LINE
 660 FT. FROM E. LINE
 _____ FT. FROM W. LINE

LOCATION _____

RIG UP

DRILLING AND REMARKS:

RECORD

CASED _____ IN., _____ FT.
 SAND _____
 GAS _____
 OIL _____
 TOTAL DEPTH _____

PRODUCTION

1ST 24 HRS. NAT. _____
 1ST 24 HRS. AFTER SHOT _____
 GAS _____ CU. FT.
 DRY HOLE _____
 ABANDONED _____

DATE

OCT 17 1928

CHAS. L. SHERWOOD
192 SCOUT

K14 KANSAS

Map No. Sec. 31 Twp. 26 R. 6

Well No. 1 Minger

O.V. Paul et al Company

Contractor

COMPLETED

SECTION PLAT

Ft. from N. Line

750 Ft. from S. Line

660 Ft. from E. Line

Ft. from W. Line

ABANDONED

Location

Rig up

Drilling and Remarks:

no sand
Top line 2772'
Dra 2804

RECORD

Cased in., ft.

Sand

Gas

Oil 2804

Total Depth 2804

PRODUCTION

1st 24 hrs. Nat.

1st 24 hrs. after shot

Gas Cu. Ft.

Dry Hole ✓

Abandoned ✓

Date

JAN 2 1929

CHAS. L. SHERWOOD

192

Scout