

Map No. *Kansas* Sec. *9* Twp. *25* R. *2^E*

Well No. *1* *Harrison* Farm


Smith et al Company

_____ Ft. from N. Line

300 Ft. from S. Line

_____ Ft. from E. Line

300 Ft. from W. Line

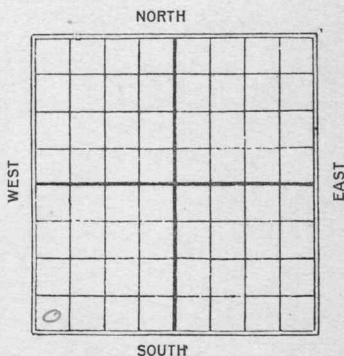

Beneas

Date REPORT

Date	REPORT
<i>1925</i>	
<i>4/23</i>	<i>Spud. + S.D.</i>
<i>6/5</i>	_____
<i>7/5</i>	_____
<i>7/21</i>	_____
<i>7/29</i>	_____
<i>8/5</i>	_____
<i>8/19</i>	_____
<i>8/27</i>	_____
<i>9/2</i>	_____
<i>9/19</i>	_____
<i>9/30</i>	_____
<i>10/6</i>	_____
<i>10/13</i>	_____
<i>10/21</i>	_____
<i>10/28</i>	_____
<i>11/4</i>	_____
<i>11/8</i>	_____
<i>1926</i>	
<i>4/14</i>	_____
<i>4/21</i>	_____
<i>4/29</i>	_____

5/5 - Spud - S. D.
5/12 - Same.
5/26 - Same
6/2 - _____
6/9 - _____
6/16 - _____
6/23 - _____
6/30 - _____
7/14 - _____
7/27 - _____
8/11 - _____
8/18 - _____
8/25 - _____
9/1 - _____
9/8 - Spud & S. D.
9/15 - _____
9/22 - _____
9/29 - _____
10/6 - _____
10/13 - Same
10/20 - _____
10/27 - _____
11/3 - _____
11/10 - _____
11/17 - _____
11/24 - _____
12/1 - _____
12/8 - _____
12/15 - _____
12/21 - _____
12/29 - _____
Feb 1
1/5 - _____
1/12 - _____
1/19 - _____
1/26 - Abandoned - Dry

13 **KANSAS** Sec. 9 Twp. 25 R. 2E

Well No. 1 - HARRISON

SMITH ET AL. Company

Contractor

FIRST REPORT

SECTION PLAT

----- Ft. from N. Line

300' Ft. from S. Line

----- Ft. from E. Line

300' Ft. from W. Line

Location -----

Rig up -----

Drilling and Remarks:

spud + S.D.

RECORD

Cased ----- in., ----- ft.

Sand -----

Gas -----

Oil -----

Total Depth -----

PRODUCTION

1st 24 hrs. Nat. -----

1st 24 hrs. after shot -----

Gas ----- Cu. Ft.

Dry Hole -----

Abandoned -----

Date

APR 23 1925

M. A. BENEAR

192

Scout

13 *Seelyweeb*
Map No. **KANSAS** Sec. *9* Twp. *25* R. *2E*

Well No. *1 Harrison*

Smith & Co. Company

Contractor

SECTION PLAT

----- Ft. from N. Line

300 Ft. from S. Line

----- Ft. from E. Line

300 Ft. from W. Line

ABANDONED

Location -----

Rig up -----

Drilling and Remarks:

Spud

J & A.

RECORD

Cased ----- in., ----- ft.

Sand -----

Gas -----

Oil -----

Total Depth -----

PRODUCTION

1st 24 hrs. Nat. -----

1st 24 hrs. after shot -----

Gas ----- Cu. Ft.

Dry Hole -----

Abandoned -----

Date

JAN 26 1927

192

S. J. LEWIS

Scout

MAP NO. K13 SEC. 9 TWP. 25S R. 2E

WELL NO. 1 Harrison
Smith & Keller COMPANY

CONTRACTOR

SECTION PLAT

_____ FT. FROM N. LINE
 _____ FT. FROM S. LINE
 _____ FT. FROM E. LINE
 _____ FT. FROM W. LINE

No Record

LOCATION _____ ✓

RIG UP _____

DRILLING AND REMARKS:

*We show
Abandoned
Location*

RECORD

CASED _____ IN. _____ FT.
 SAND _____
 GAS _____
 OIL _____
 TOTAL DEPTH 900

PRODUCTION

1ST 24 HRS. NAT. _____
 1ST 24 HRS. AFTER SHOT _____
 GAS _____ CU. FT.
 DRY HOLE _____
 ABANDONED

DATE

5/26 1926

SCOUT