


Barton

KANSAS

Section 31 Township 20 Range 13W

Well Number 2 Hiss

Company Simpson Oil Co.

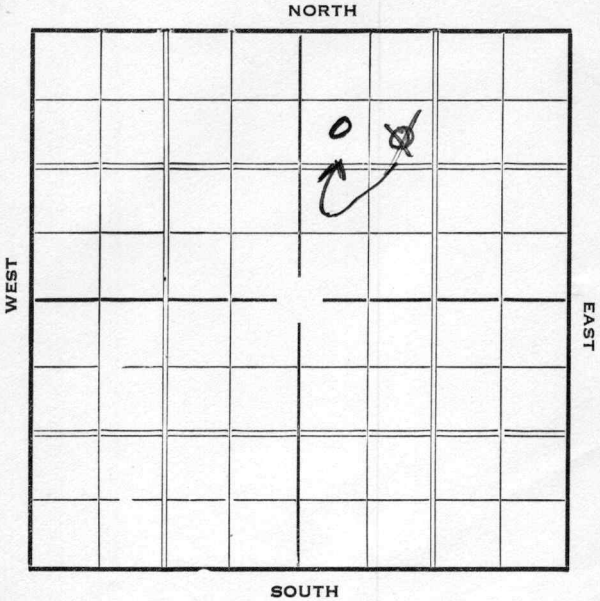

*3/9/36
Admitted
correct*

Map No. _____ Sec. 31 Twp. 20 R. 13-W

Well No. #2 Hiss Farm _____


Simpson Oil Company _____

990 Ft. from N. Line

_____ Ft. from S. Line

_____ Ft. from E. Line

330
~~990~~ Ft. from W. Line

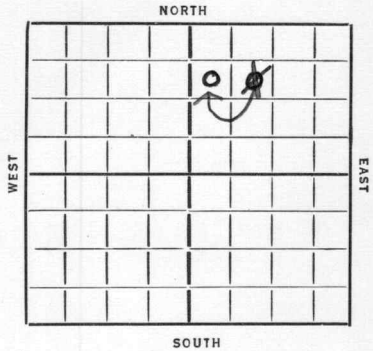

El. 1904

Date	REPORT
1936	
12/22	Location
12/29	Surface hole.
1937	
1/7	13" @ 154'. Drlg. 2270'.
1/14	Lansing 3188'. Drlg. 3240' show gas.
1/21	6" @ 3232'. T. D. 3280' RUST.
1/28	RUST.
2/4	T. D. 3247'. 22½ M gas.
2/11	" " " " "
2/18	" " " " "
2/26	T.D. 3290'. 5000 acid. Potential 1053 bbls in 12 hrs.
3/3	Lansing 3188'.
	T. D. 3290'.
	5000 acid.
	Potential 1701.
	COMPLETED

KANSAS

Map No. 82 Sec. 31 Twp. 20 R. 13W

Well No. 2 Hiss

Simpson Oil Company

Contractor _____

SECTION PLAT

		o	

990 Ft. from N. Line

_____ Ft. from S. Line

_____ Ft. from E. Line

990 Ft. from W. Line

FIRST REPORT

Location ✓

Rig up _____

Drilling and Remarks:

RECORD

Cased _____ in., _____ ft.

Sand _____

Gas _____

Oil _____

Total Depth _____

PRODUCTION

1st 24 hrs. Nat. _____

1st 24 hrs. after shot _____

Gas _____ Cu. Ft.

Dry Hole _____

Abandoned _____

Date

DEC 22 1936

19

S. J. LEWIS

Scout

KANSAS

Map No. 82 Sec. 31 Twp. 20 R. 13W

Well No. 2 Hiss

Simpson Oil Company

Contractor

SECTION PLAT

		0	

990 Ft. from N. Line

_____ Ft. from S. Line

_____ Ft. from E. Line

330 Ft. from W. Line

CORRECTION

Location _____

Rig up _____

Drilling and Remarks:

*This was reported
S E N O V N E but
should be in
S W N O V N E.*

RECORD

Cased _____ in., _____ ft.

Sand _____

Gas _____

Oil _____

Total Depth _____

PRODUCTION

1st 24 hrs. Nat. _____

1st 24 hrs. after shot _____

Gas _____ Cu. Ft.

Dry Hole _____

Abandoned _____

Date

3/3

1937

S. J. LEWIS

Scout

Map No. _____ Sec. 31 Twp. 20 R. 13W

Well No. 2 Hiss

Simpson Oil Company

Contractor _____

SECTION PLAT

990 Ft. from N. Line
____ Ft. from S. Line
____ Ft. from E. Line
330 Ft. from W. Line

		0	

COMPLETED

Location _____

Rig up _____

Drilling and Remarks:

*Lansing 3188.
5000 gal
Potential
1701*

RECORD

Cased _____ in., _____ ft.
Sand _____
Gas _____
Oil _____
Total Depth 3290

PRODUCTION

1st 24 hrs. Nat. _____
1st 24 hrs. after shot _____
Gas _____ Cu. Ft.
Dry Hole _____
Abandoned _____

Date

3/3 1937

S. J. LEWIS Scout