


Map No. Kaw Sec. 32 Twp. 26 R. 6

Well No. 1 Webber Farm
Lewis Oil Company

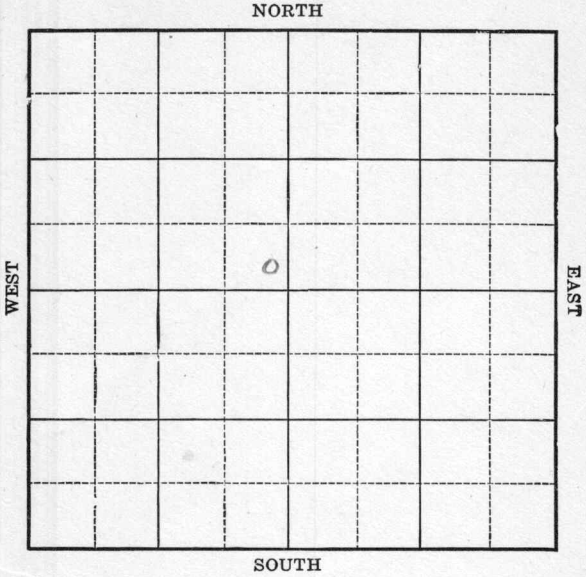

Location _____
Drilling Remarks _____

Rig Up _____
Drilling Remarks _____

RECORD

Cased _____ in. _____ ft.
Sand _____
Gas _____
Oil _____
Total Depth _____

PRODUCTION

1st 24 hrs. Nat. _____
1st. 24 hrs. after shot _____
Gas _____ cu. ft.
Dry Hole _____
Abandoned _____


Map No. Kan Sec. 32 Twp. 26 R. 6Well No. 1 Hebber FarmLewis Oil Co. Company

Ft. from N. Line

250 Ft. from S. Line250 Ft. from E. Line

Ft. from W. Line

NORTH

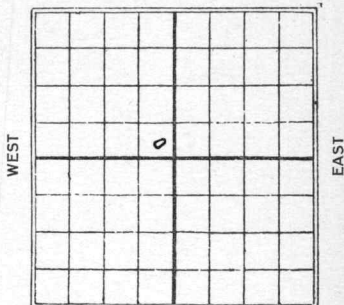

SOUTH

Date 1925 REPORT7/17 Rig & Tools7/24 Spudding.7/31 250'8/7 1450'8/14 2100'8/20 6" 2552 - D 2500'8/27 sand shell 2760 - 63set 5" 2818 U.R. to 2900' T.D.9/3 —9/11 2769 - 2790 T.D. 290020 gals 25 Bbls

Map No. 45446 Sec. 32 Twp. 26 R. 6
 Well No. 1 Webber
Lewis and Co Company

Contractor

FIRST REPORTS

SECTION PLAT

Ft. from N. Line

250 Ft. from S. Line

250 Ft. from E. Line

Ft. from W. Line

Location

Rig up

Drilling and Remarks:

RECORD

Cased _____ in., _____ ft.

Sand _____

Gas _____

Oil _____

Total Depth _____

PRODUCTION

1st 24 hrs. Nat. _____

1st 24 hrs. after shot _____

Gas _____ Cu. Ft.

Dry Hole _____

Abandoned _____

Date

JUL 17 1925

CHAS. L. SHERWOOD

192

Scout

Map No. KANSAS Sec. 22 Twp. 26 R. 6Well No. 1 HebblerLewis oil Co Company

Contractor

COMPLETED

SECTION PLAT

Ft. from N. Line

250

Ft. from S. Line

250

Ft. from E. Line

Ft. from W. Line

Location

Rig up

Drilling and Remarks:

L.D. 2900' pluggedBack to land2769-2790'207 75 bhs

RECORD

Cased _____ in., _____ ft.

Sand _____

Gas _____

Oil _____

Total Depth _____

PRODUCTION

1st 24 hrs. Nat. _____

1st 24 hrs. after shot _____

Gas _____ Cu. Ft.

Dry Hole _____

Abandoned _____

Date

SEP 11 1925

192

CHAS. L. SHERWOOD

Scout