


Section 36 Township 25 Range 8 E

Well No. #1 Bryden A/C

Company Ohio Oil

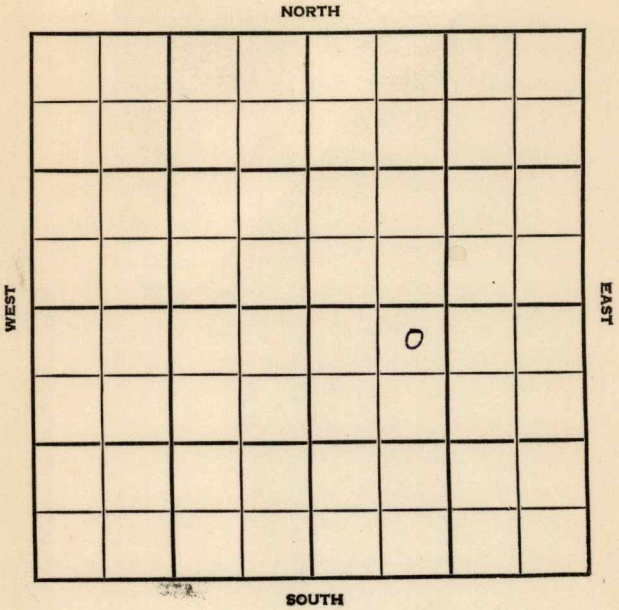

Greenwood

KANSAS

SEC.

TWP.

R.

36

25

8 E

WELL NO.

1 Bryden A/C

FARM

COMPANY

Ohio Oil

CONTRACTOR

McGinnis


Sallyards

Ft. from N. Line

Ft. from S. Line

Ft. from E. Line

Ft. from W. Line

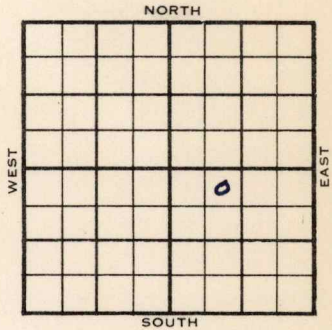

NE NW SE

ELEVATION

REPORT

1955

10/12

Comm. 8-8-55

Bartl 2318'

8" @ 108' TD 2360'

7" @ 2317' CO to 2360'

PB 2338' Frac

Comp. 18 BOPD 3 BW

FIRST REPORT

COMPLETED

County Greenwood Elev. _____
 Sec. 36 Twp. 25 Rge. 8E
 Company Ohio Oil
 Farm Name Bryden A/C No. 1

TOPS	DEPTH	LOG	DATUM	Loc. in Sec.
Anh.				<u>NE NW SE</u>
Tp.				
H.				
Tr.				
Dg.				
Bl.				
L.				Geol. _____
K.C.				Contr. _____
B.K.C.				<u>McGinnis</u>
Ce.				Pool _____
C.				<u>Sallyards</u>
M.				
M.				
K. <u>Bartl</u>	<u>2318</u>			
Mz.				
Ma.				
V.				
S.				
S.				
A.				
R.				
Pe.				
G.				
T.D.				

FIRST REPORT
 OCT 12 55
COMPLETE

Date Comm. 8-8-55
8 " @ 108 TD 2360 7" @ 2317
CO to 2360 PB 2338 frac
Comp. 18 bopd 3bw